


T.11S.R.7W.W.M.

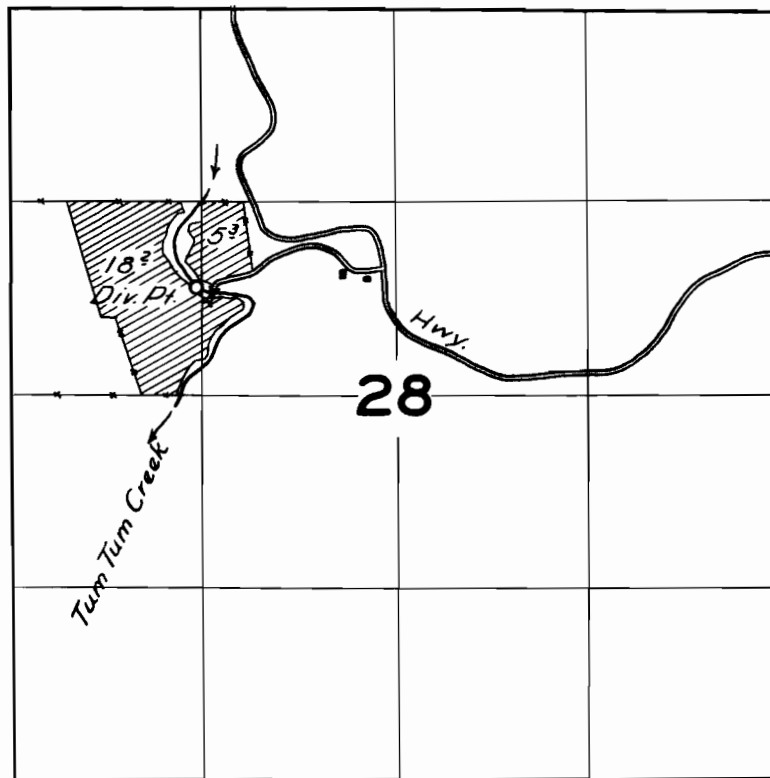

FINAL PROOF SURVEY
UNDER

Application No. 27028 Permit No. 21270
IN NAME OF

Surveyed 5 Sept. 1957, by *P. W. Kelly*