


T. 34 S., R. 1 W., W.M.

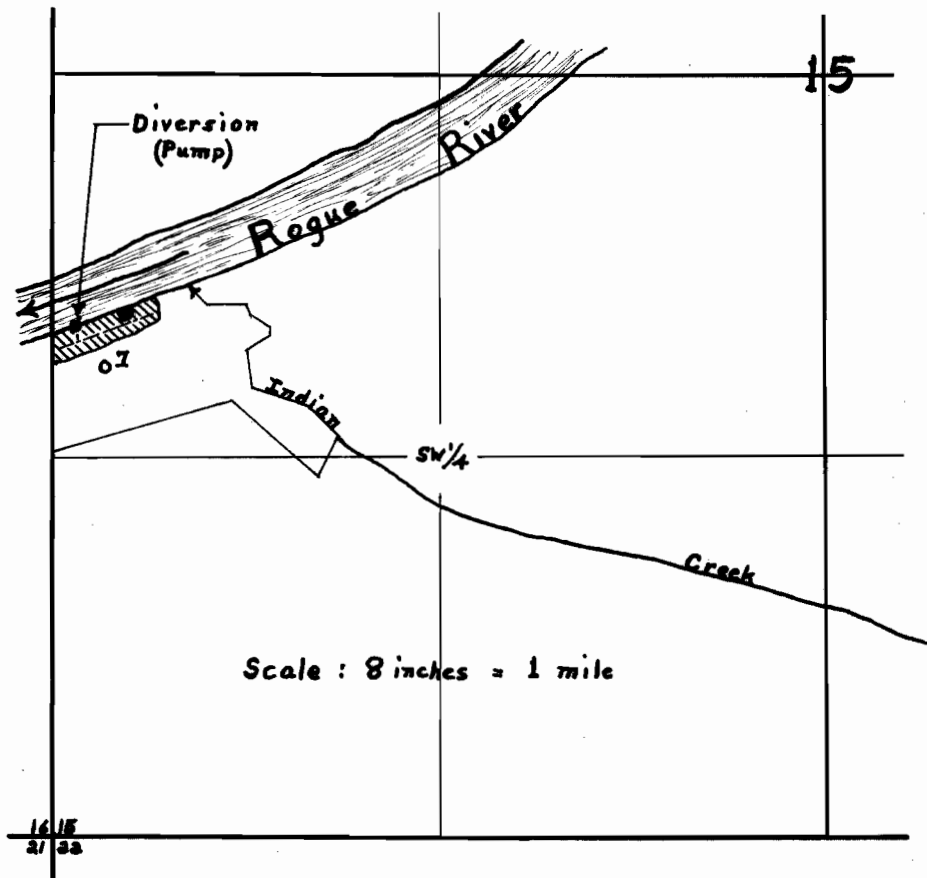

FINAL PROOF SURVEY

UNDER

Application No. 22472 Permit No. 23190

IN NAME OF

Joseph P. Vachon

Surveyed June 15, 1956, by D.C. Hendrix

RECEIVED
AUG 30 1956
STATE ENGINEER
WILLIAM JOHNSON