


T.36S.R.1&2E.W.M.

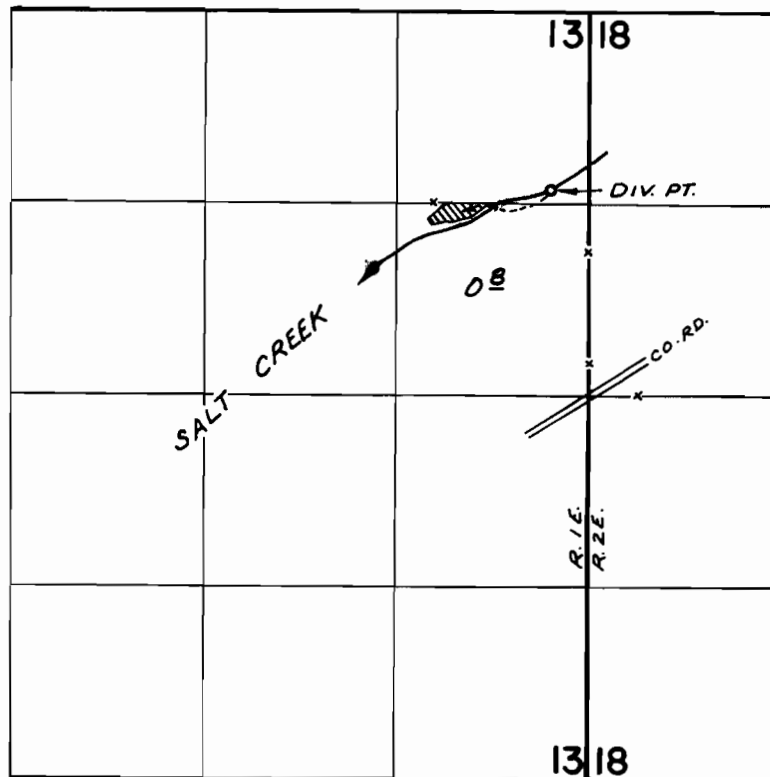

DIV. PT. LOC: 1420' N & 260' W. FROM E 1/4 COR. SEC. 13

FINAL PROOF SURVEY
UNDER

TRANSFER NO. B-182

Application No. _____ Permit No. _____
IN NAME OF

CHARLES F. & ELYNOR P. BAYLEY

Surveyed JUNE 4, 1974, by R. MUCKEN