


T.27 S.R.15 E.W.M.

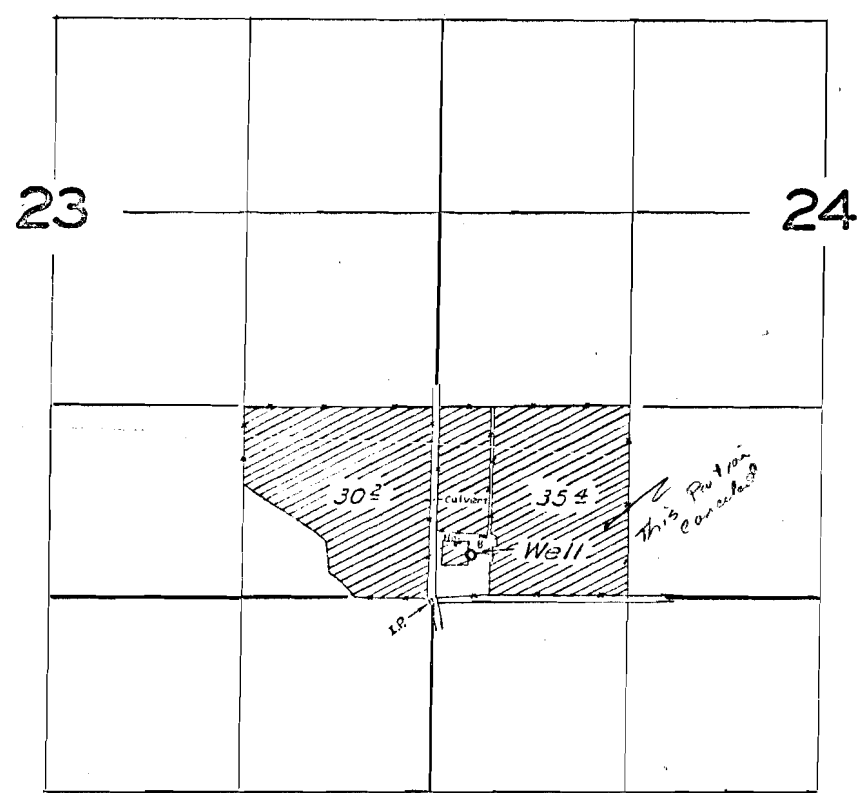

FINAL PROOF SURVEY UNDER

Application No. U-439 Permit No. U-410
IN NAME OF

DARREL G. BOWEN

Surveyed 6 May 1959 by M. Bish