


T.15&16S.R.4W.W.M.

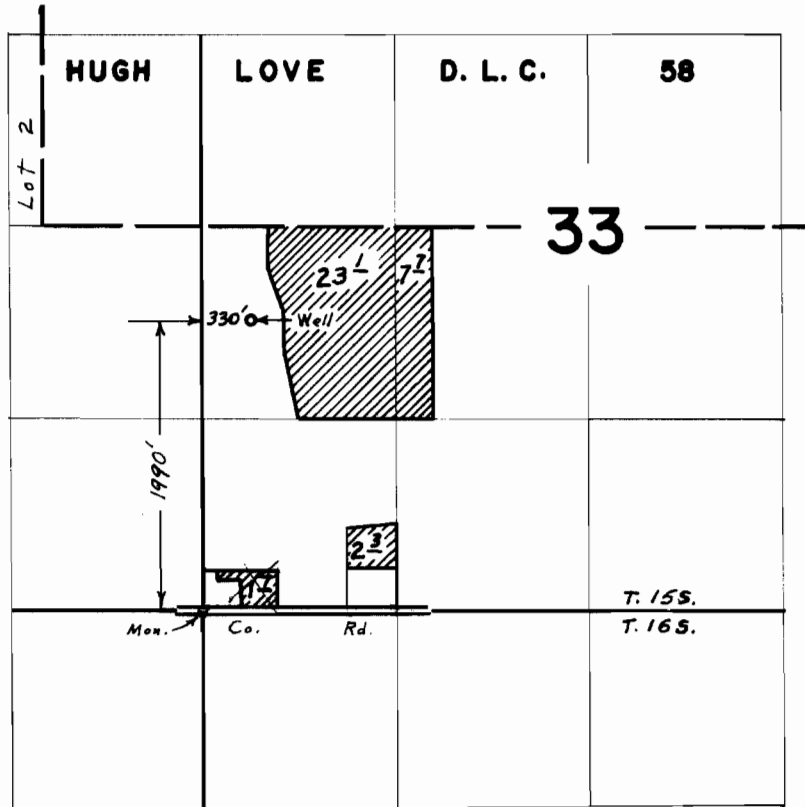

FINAL PROOF SURVEY UNDER

Application No. G-3136 Permit No. G-2932
 IN NAME OF
ARTHUR G. & ESTHER M. JAGER

Surveyed APRIL 27 1967, by L. E. GOULD