


T. 5 & 6 S. R. 2 W. W.M. .

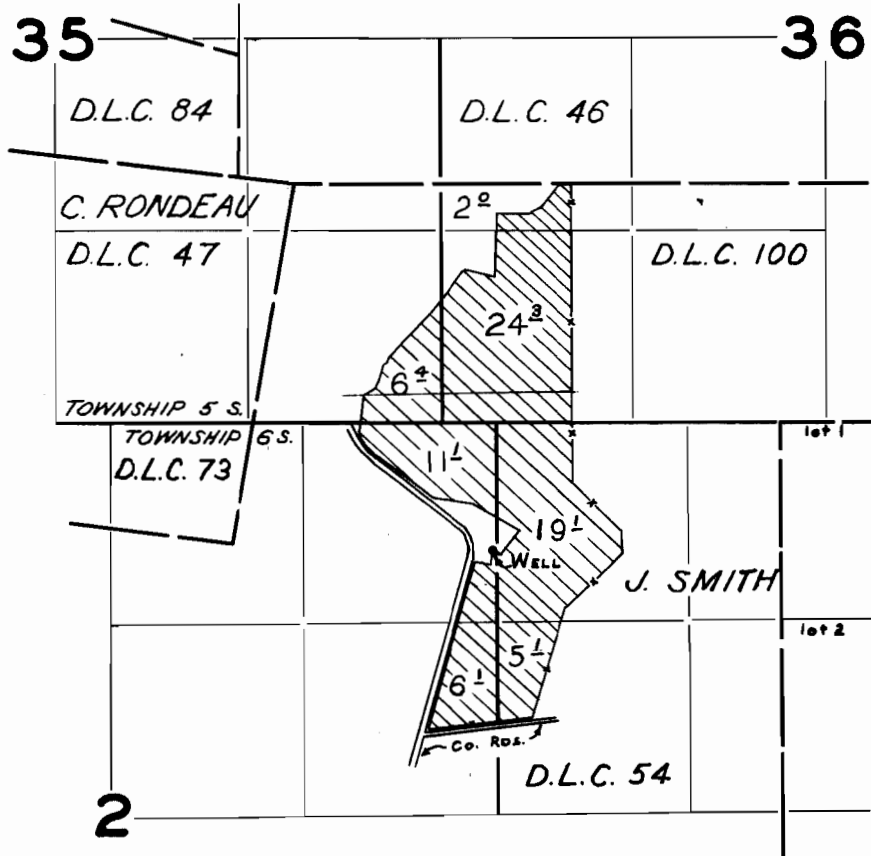

FINAL PROOF SURVEY
UNDER

Application No. G-2376 Permit No. G-2187
IN NAME OF

JOHN ZELLNER

Surveyed JUN. 25 1964, by R. JACKSON