


T.6&7 S. R.2 W. W.M.

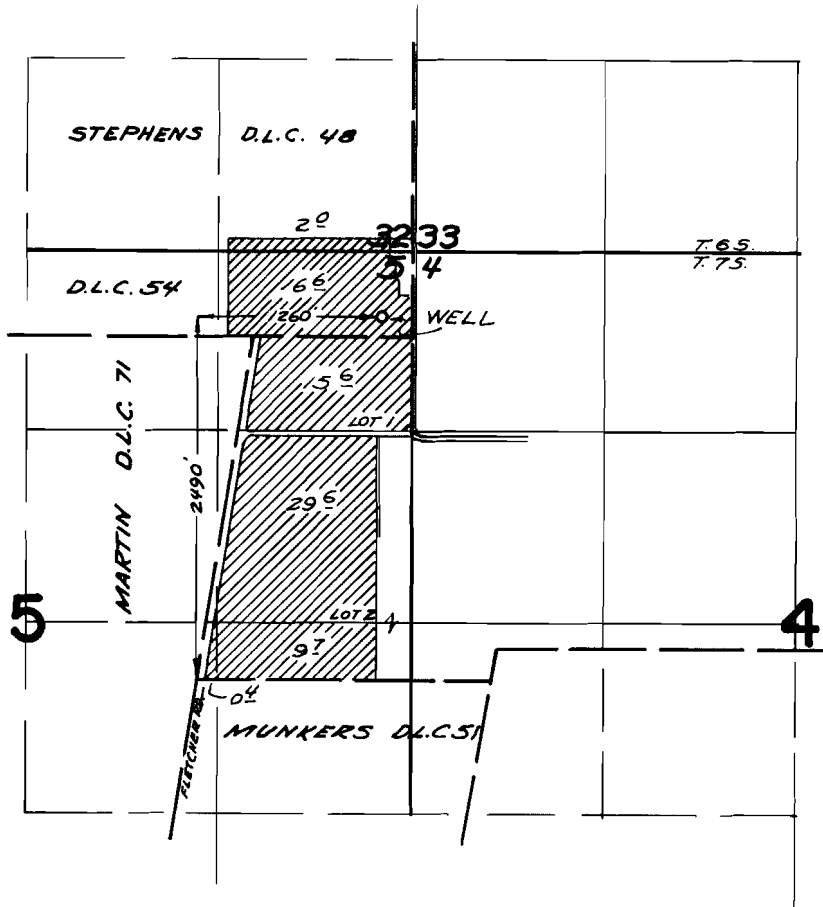

FINAL PROOF SURVEY
UNDER

Application No. *G:2866*. Permit No. *G:2783*...
IN NAME OF

HEUBERT GALLE

Surveyed *June 20, 1968*, by *V. Garner*....