


T. 7S. R. 1E. W.M.

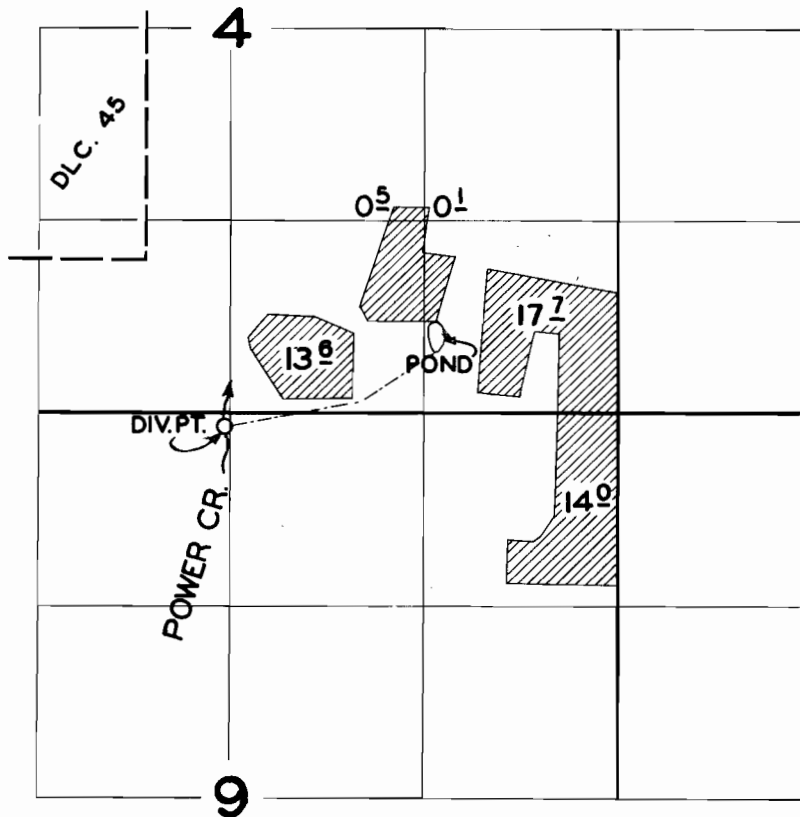

**FINAL PROOF SURVEY**  
UNDER

Application No. 26239 Permit No. 20604  
IN NAME OF

**BRADFORD A. EDWARDS**

Surveyed SEPT. 6 1957, by *C. O. Burtels*