


T.4S.,R.4E.,W.M.

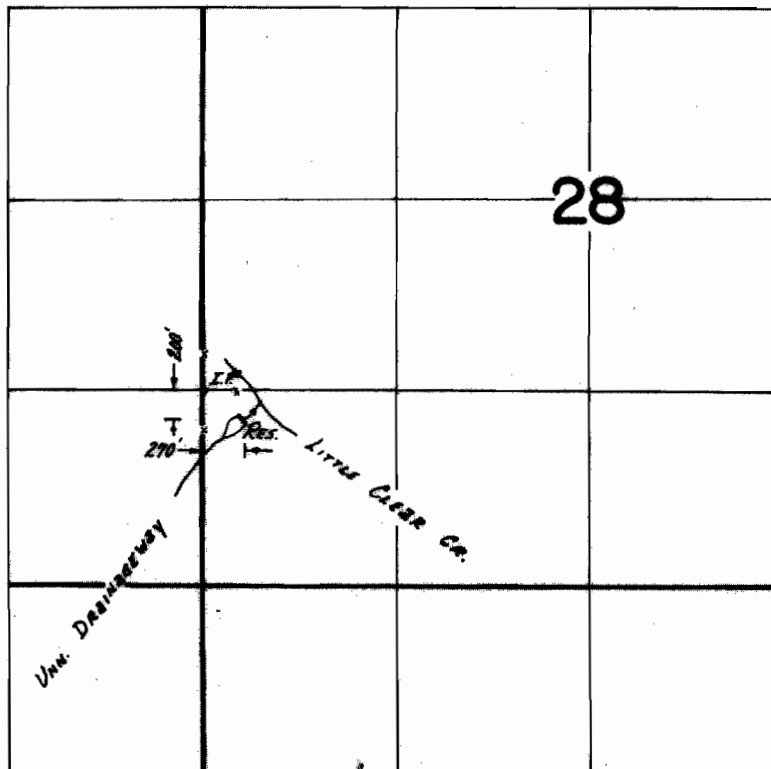

FINAL PROOF SURVEY
UNDER

Application No. R-45993 45912 Permit No. R-5470 34300

IN NAME OF

S. M. Ball

Surveyed Dec. 1 1973, by R. G. MUCKEN