


T.6S.R.7W.W.M.

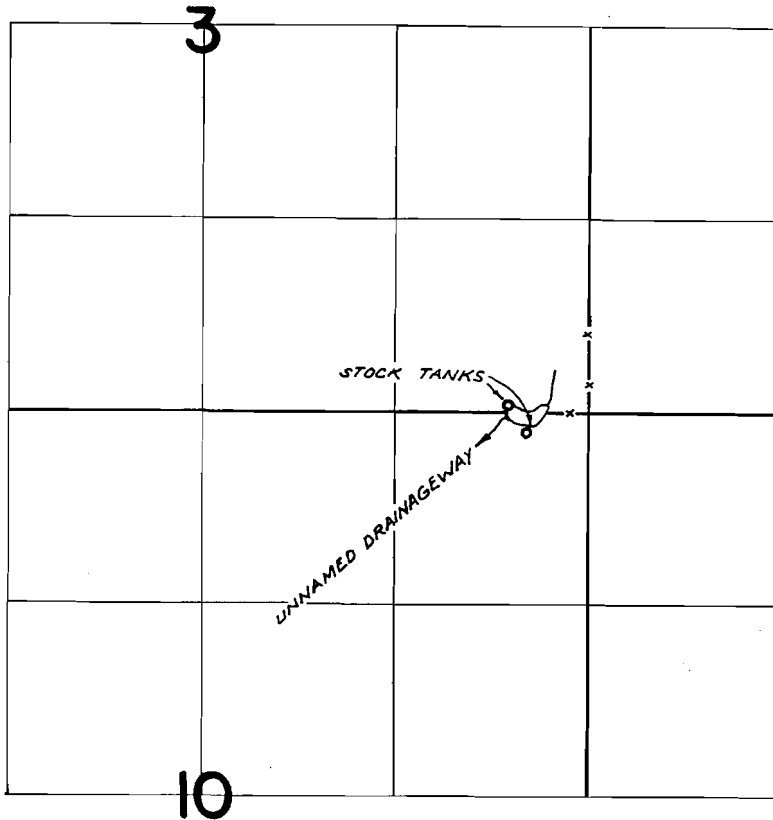

DIV. PT. LOC: 30'S. & 570'W. FROM N.E. COR. SEC.10

FINAL PROOF SURVEY UNDER

Application No. R-48152 48153 Permit No. R-5645 35228
IN NAME OF

ROBERT W. STRAUB

Surveyed MAR. 24, 1975, by L. TOLL