


T. 7S. R. 41E. W.M.

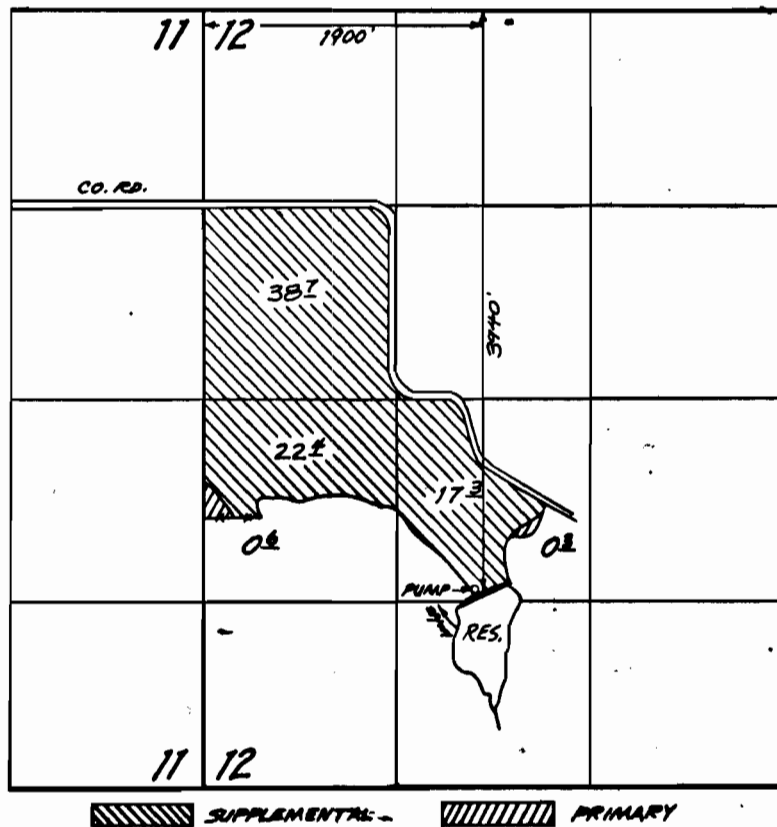

FINAL PROOF SURVEY UNDER

R 42600 R 4912
Application No. 42601 Permit No. 52201
IN NAME OF

JOE H. WIRTH

Surveyed OCT. 25 1974, by L.M. TOLL