


# T. 7S. R. 41E. W.M.

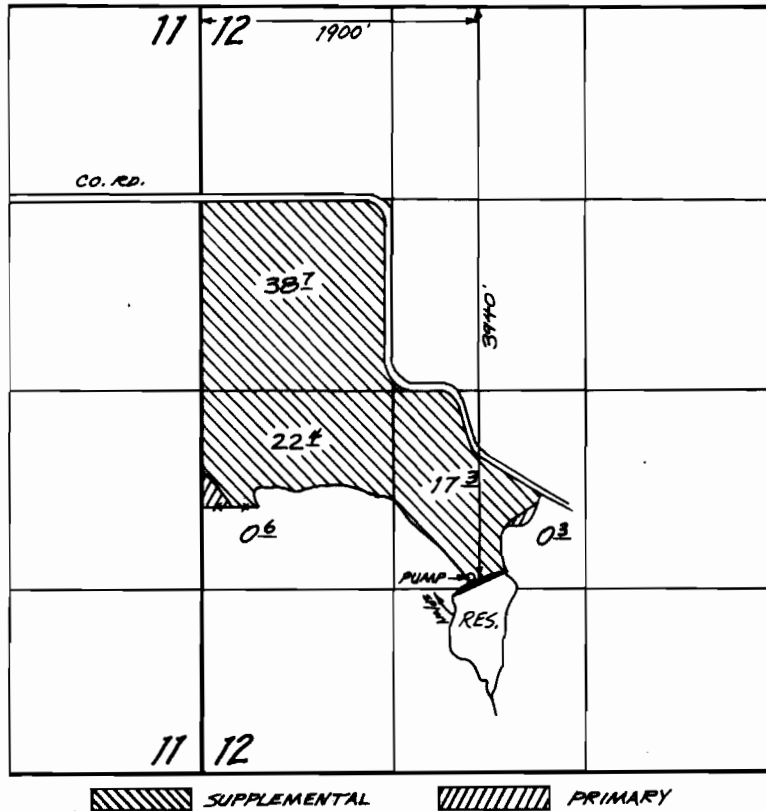

## FINAL PROOF SURVEY UNDER

Application No. R 42600 42601 Permit No. R 4912 32201  
IN NAME OF

JOE H. WIRTH

Surveyed OCT. 25 1974, by L.M. TOLL