


T. 15 S. R. 4 & 5 W. W. M.

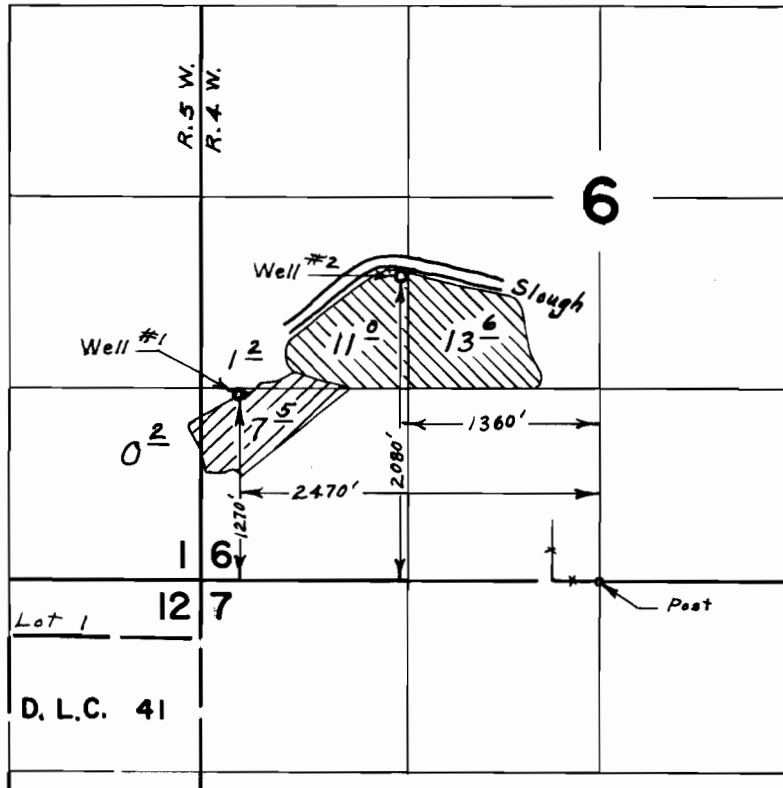

FINAL PROOF SURVEY UNDER

Application No. G-4066 Permit No. G-3811
IN NAME OF

DAN TRACER

Surveyed Aug. 20, 1970, by L. E. Gould