


T.13S., R.5W., W.M.

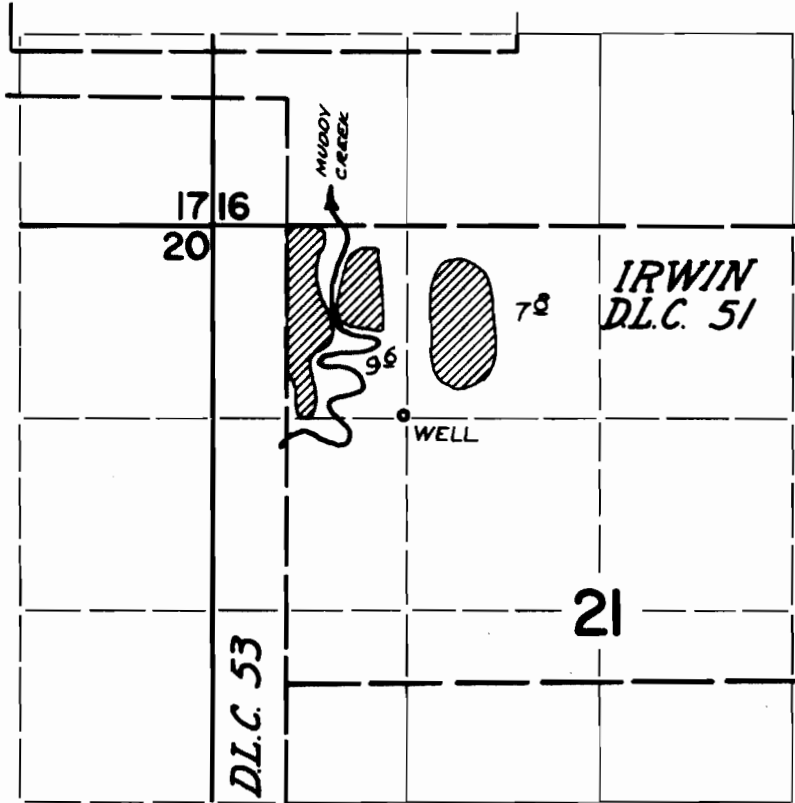

WELL LOCATED: 1300' S & 800' E FROM NW COR. IRWIN D.L.C. 51.

FINAL PROOF SURVEY
UNDER

Application No. G-1300 Permit No. G-1132
IN NAME OF

MUDDY RIVER HUNT CLUB, INC.

Surveyed June 6 1973, by D. Norby