


T.14S., R.5W., W.M.

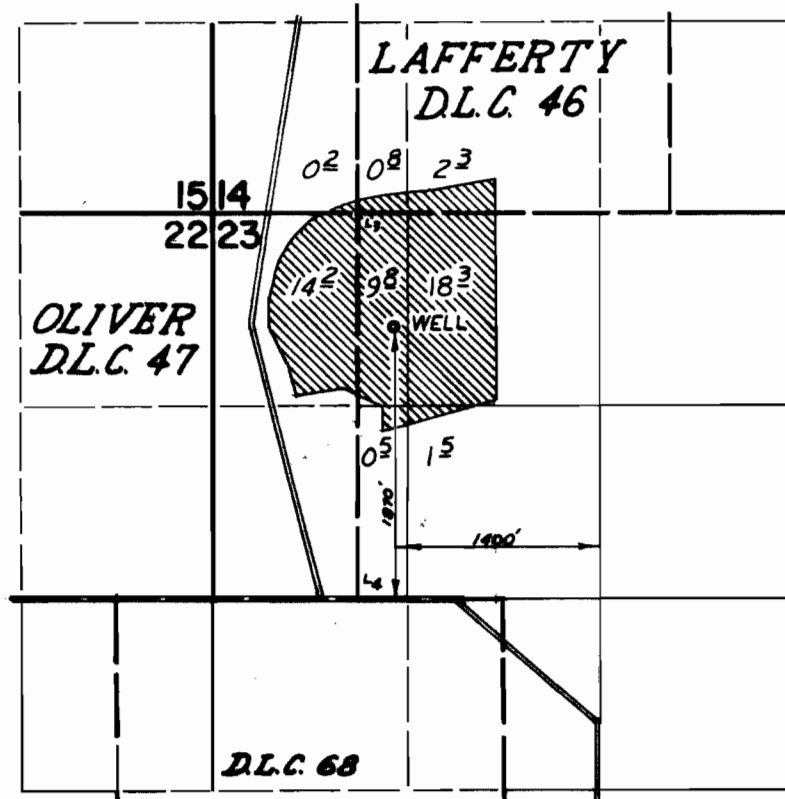

FINAL PROOF SURVEY
UNDER

Application No. G-4939 Permit No. G-4662
IN NAME OF

WILLIAM GORACKE

Surveyed APRIL 5 1973., by D. NORBY