


T.14S., R.5W., W.M.

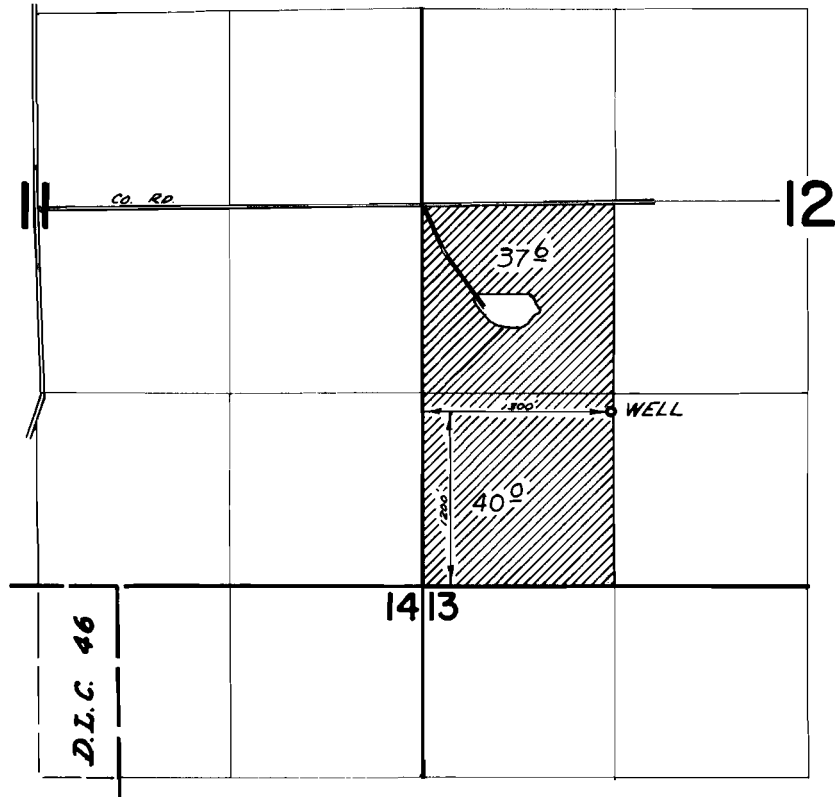

FINAL PROOF SURVEY
UNDER

Application No. G-5052 Permit No. G-4762
IN NAME OF

DAVID BARCLAY

Surveyed APRIL 4 1973, by D. NORBY