


T.14 S., R.5 W., W.M.

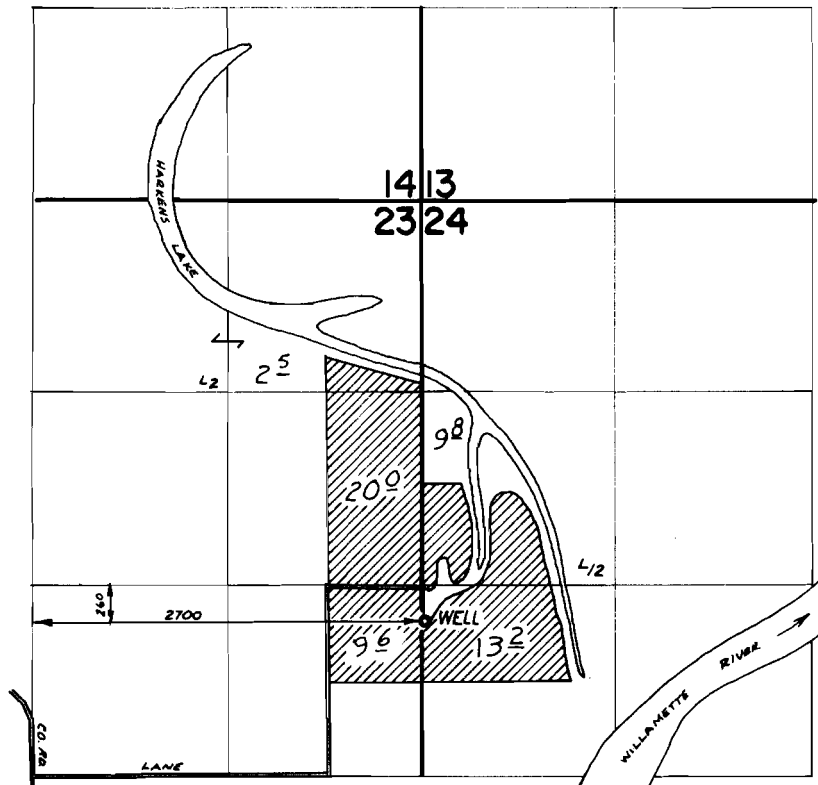

**FINAL PROOF SURVEY**  
UNDER

Application No. G-5002 Permit No. G-4798  
IN NAME OF

EMMA ANDERSON

Surveyed APRIL 5 1923, by D. Noesby