


T.9S. R.4W. W.M.

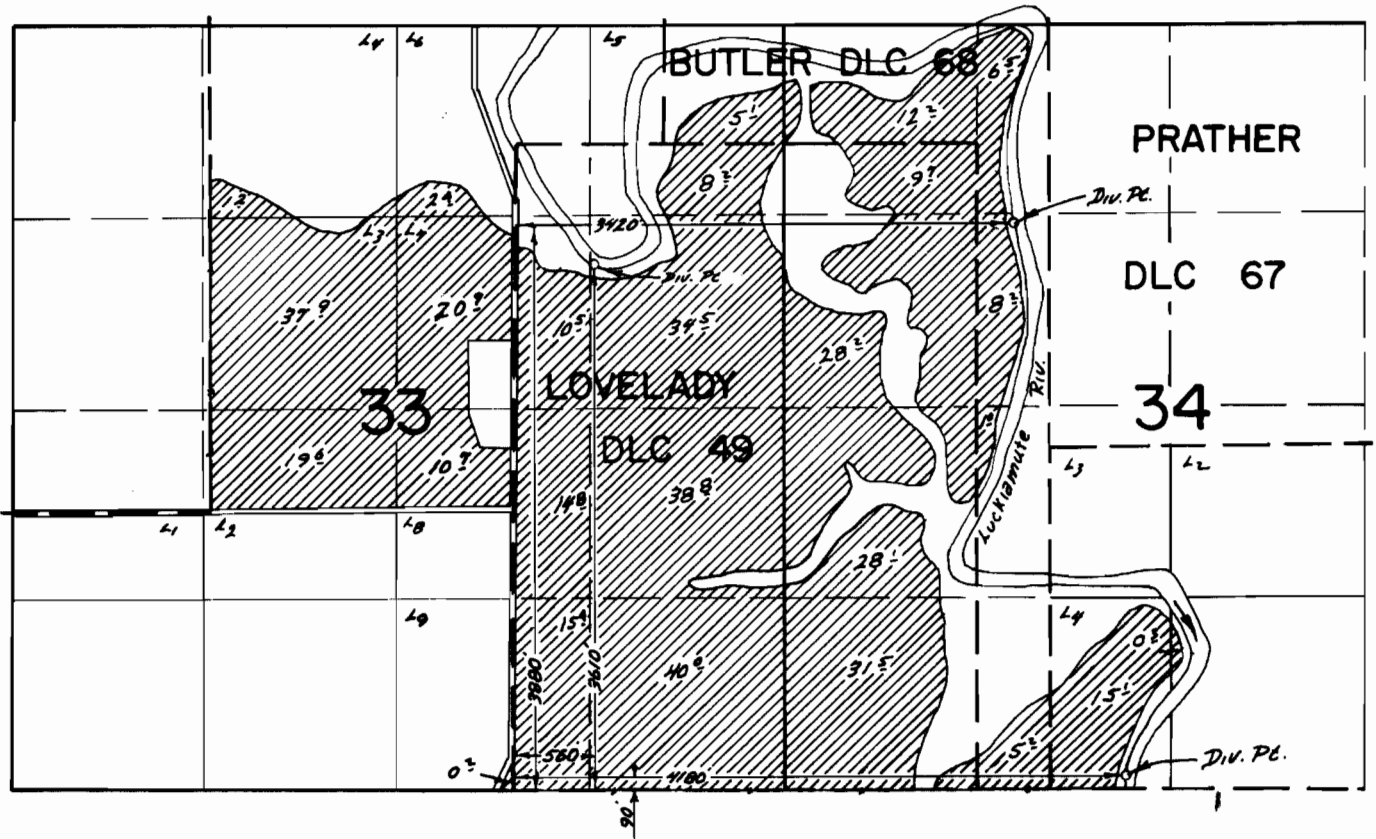

**FINAL PROOF SURVEY**  
UNDER

Application No. 92040 Permit No. 91469  
IN NAME OF

DONALD HECTOR

Surveyed March 26 1978, by R. G. Nucken