


T.10S., R.7 W., W.M.

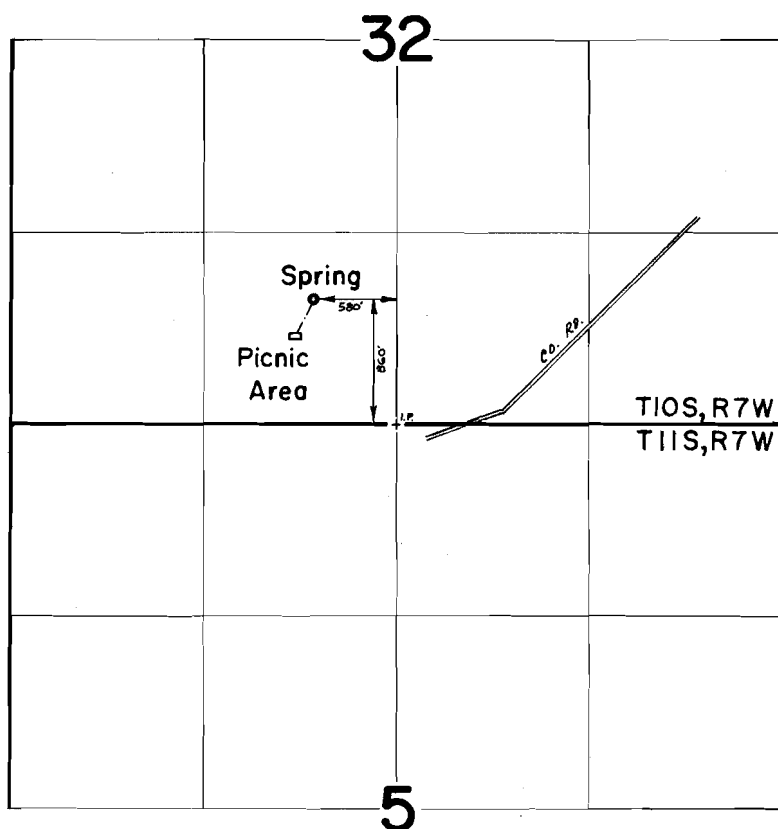

FINAL PROOF SURVEY
UNDER

Application No. 43590 Permit No. 32595
IN NAME OF

LYLE BOGENHAGEN

Surveyed March 22 1973, by D. Norby