


T.13&14S., R.7W., W.M.

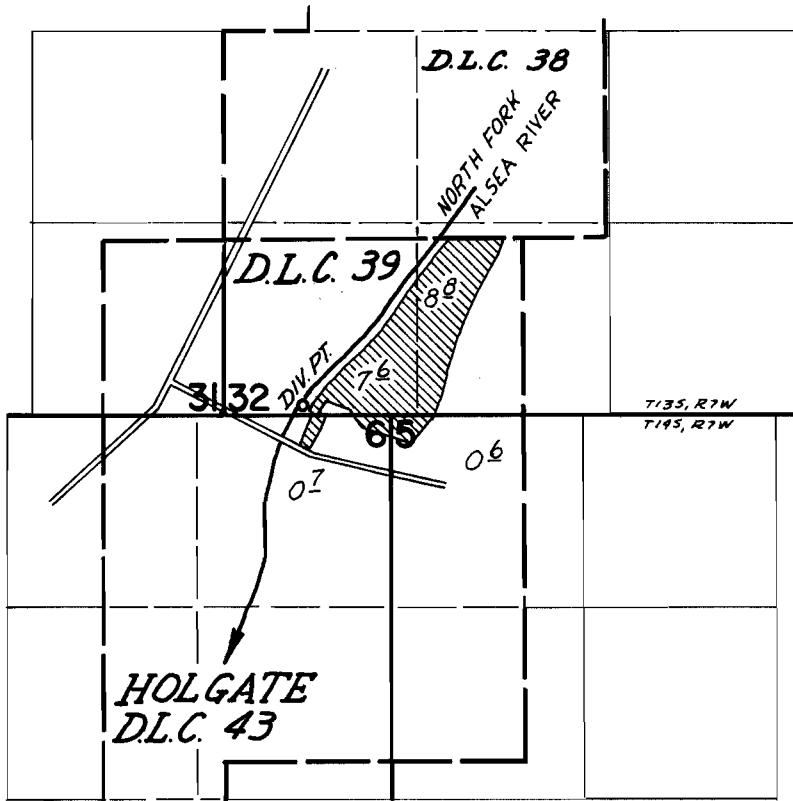

DIV. PT. LOCATED: 1140'S & 1510'W FROM NE COR. HOLGATE DLC 39.

FINAL PROOF SURVEY
UNDER

Application No. 44008 Permit No. 32899
IN NAME OF

GORDON D. REED

Surveyed August 23 1973, by D. Norby