


T. 13 S., R. 5 W., W.M.

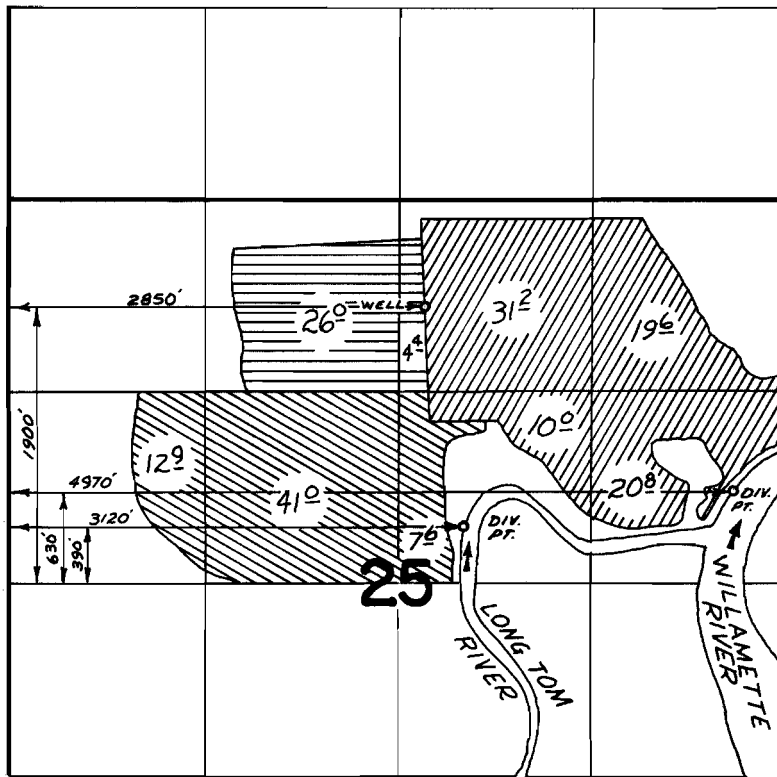

FINAL PROOF SURVEY UNDER

44147 32969
44148 32970
Application No. G-4105 Permit No. G-3853
IN NAME OF



JOHN & GEORGINA WAHL

Surveyed MAR. 30 1973, by D. NORBY