


T.14S., R.5W., W.M.

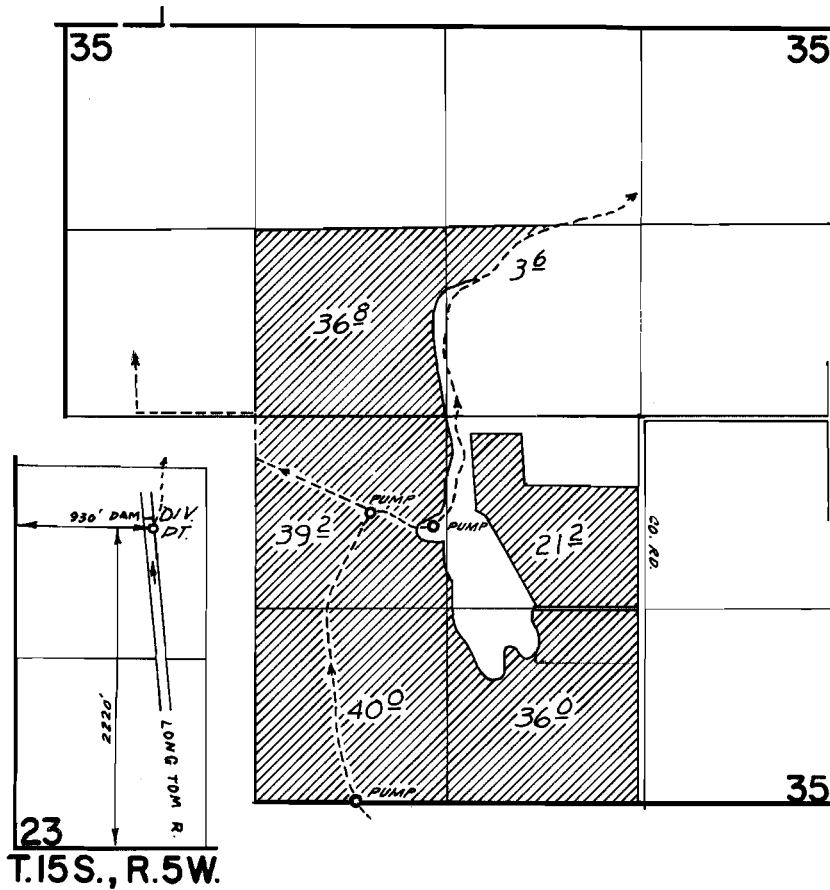

FINAL PROOF SURVEY
UNDER

Application No. 44174 Permit No. 32978
IN NAME OF

G. DAVID LOWE AND HARRIET J. LOWE

Surveyed APRIL 25 1973, by D. NORBY