


T.14S., R.5W., W.M.

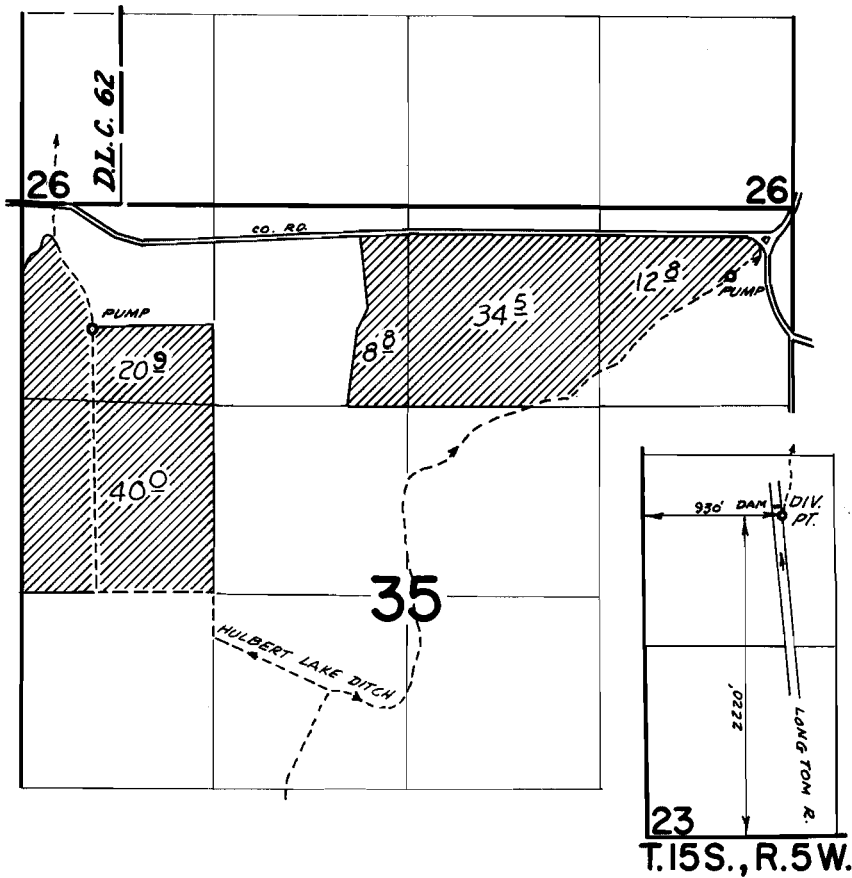

FINAL PROOF SURVEY
UNDER

Application No. 44567 Permit No. 33358
IN NAME OF

J. CHESTER OAKES

Surveyed June 8 1973, by D. Nobby