


T.14S., R.5W., W.M.

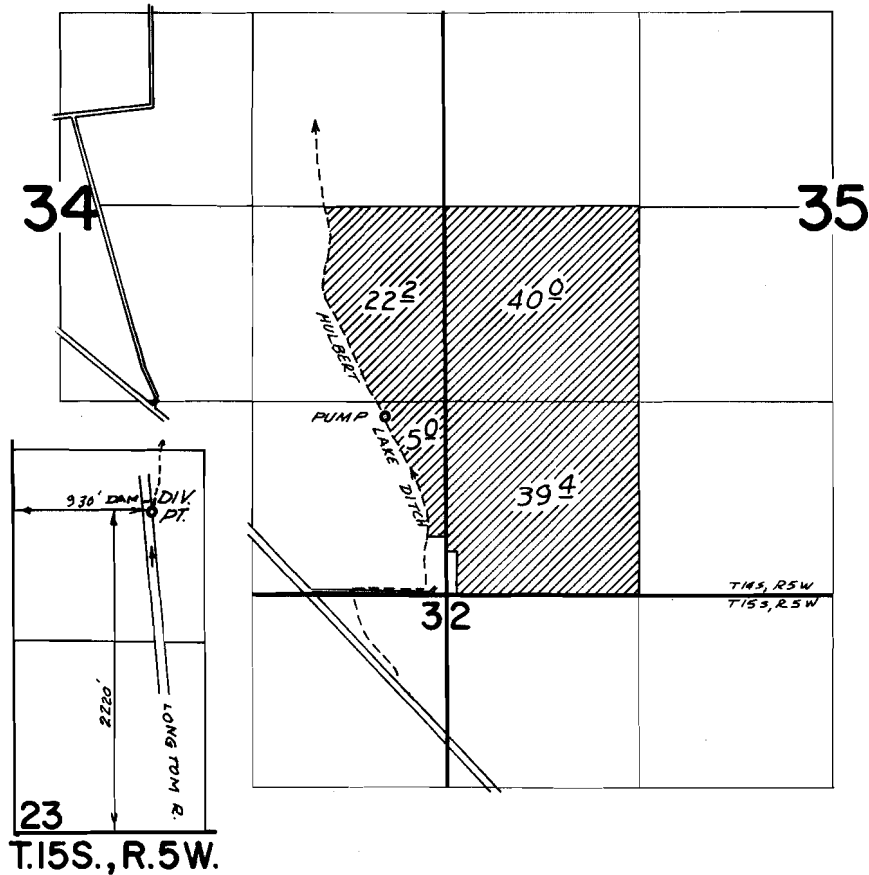

FINAL PROOF SURVEY
UNDER

Application No. 44572 Permit No. 33363
IN NAME OF

C. B. READER AND LEORA READER

Surveyed June 8 1973, by D. NORBY