


T.14 & 15S., R.5W., W.M.

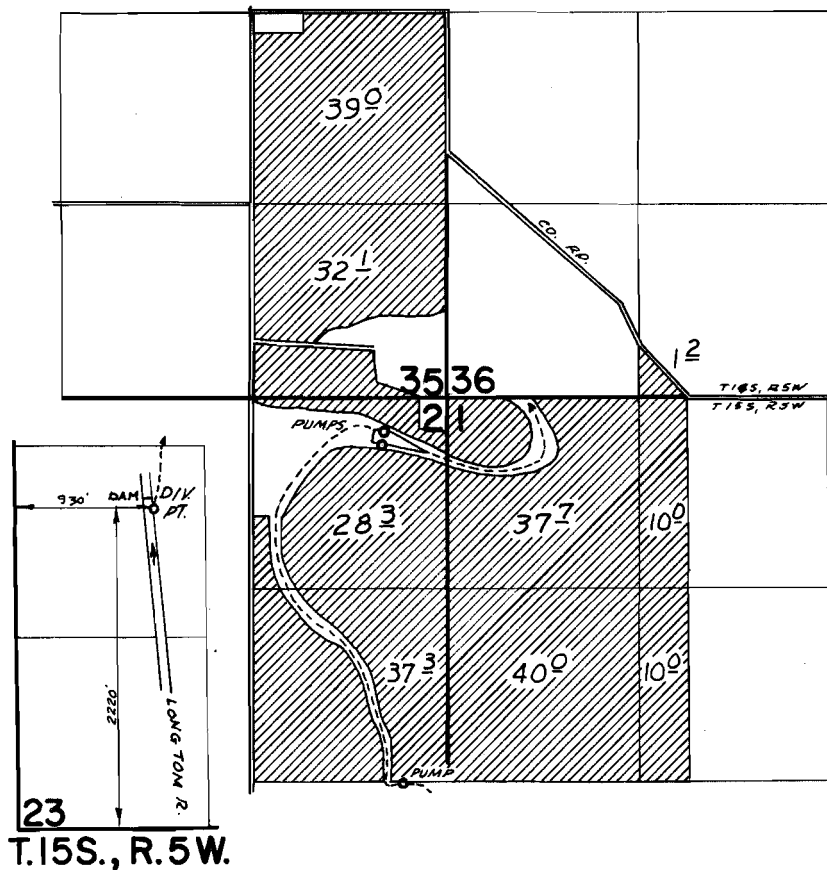

FINAL PROOF SURVEY
UNDER

Application No. 44574 Permit No. 33365
IN NAME OF

JAMES F AND BARBARA J LEMON

Surveyed SEPT 19 1973, by D. NORBY