


T.14S., R.8W., W.M.

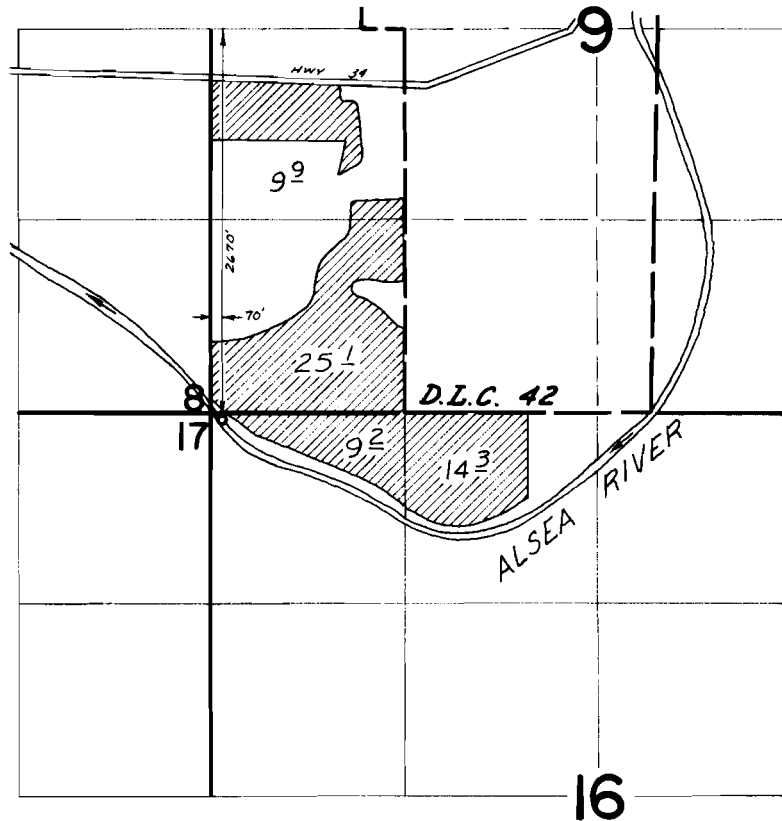

FINAL PROOF SURVEY
UNDER

Application No. 45099 Permit No. 33702
IN NAME OF

George E. & Helen M. Shroyer

Surveyed APRIL 27 1973, by D. M. NORBY