


T.14 S., R.6 W., W.M.

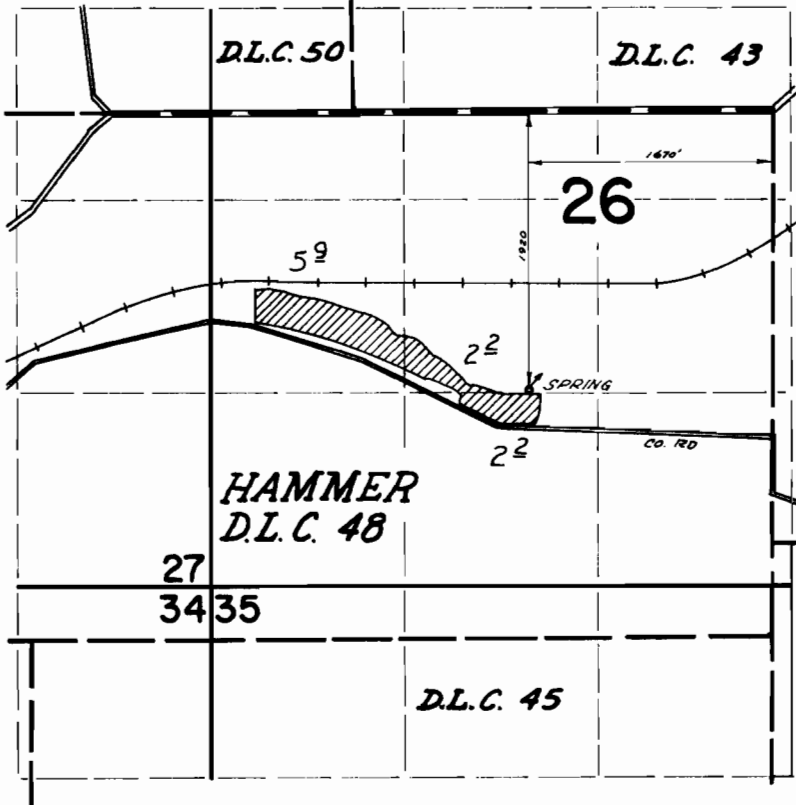

**FINAL PROOF SURVEY**  
UNDER

Application No. 45308 Permit No. 33828  
IN NAME OF

SAM & MARY PECORILLA

Surveyed June 7 1973, by D. NoeBY