


T.12 S., R.6 W., W.M.

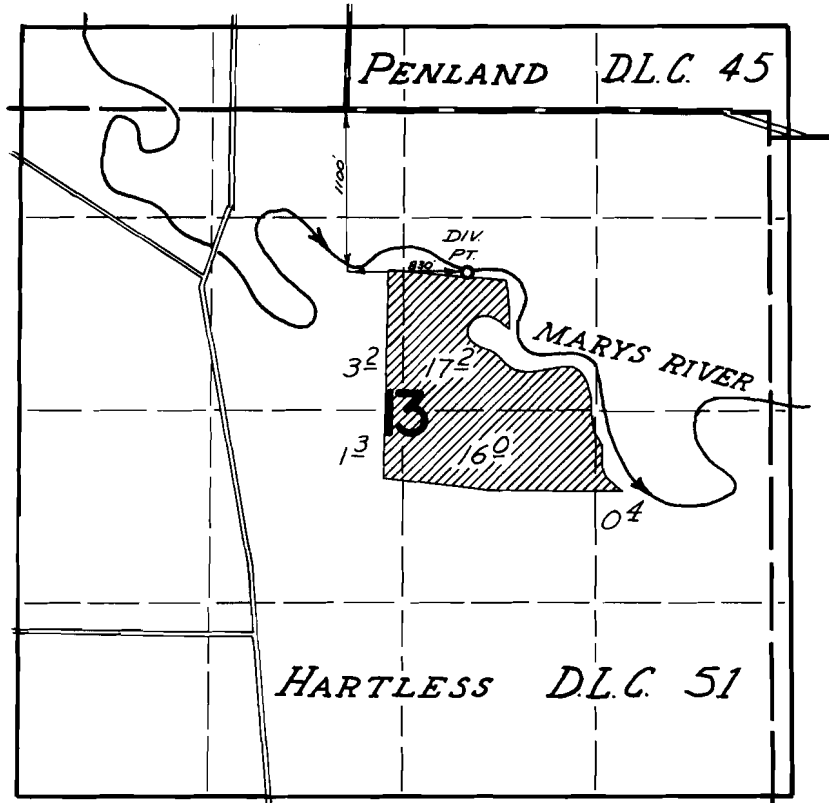

**FINAL PROOF SURVEY**  
UNDER

Application No. 45909 Permit No. 34297  
IN NAME OF

GEORGE SHROYER, JR.

Surveyed MARCH 28 1973, by D. NORBY