


T.14S., R.8W., W.M.

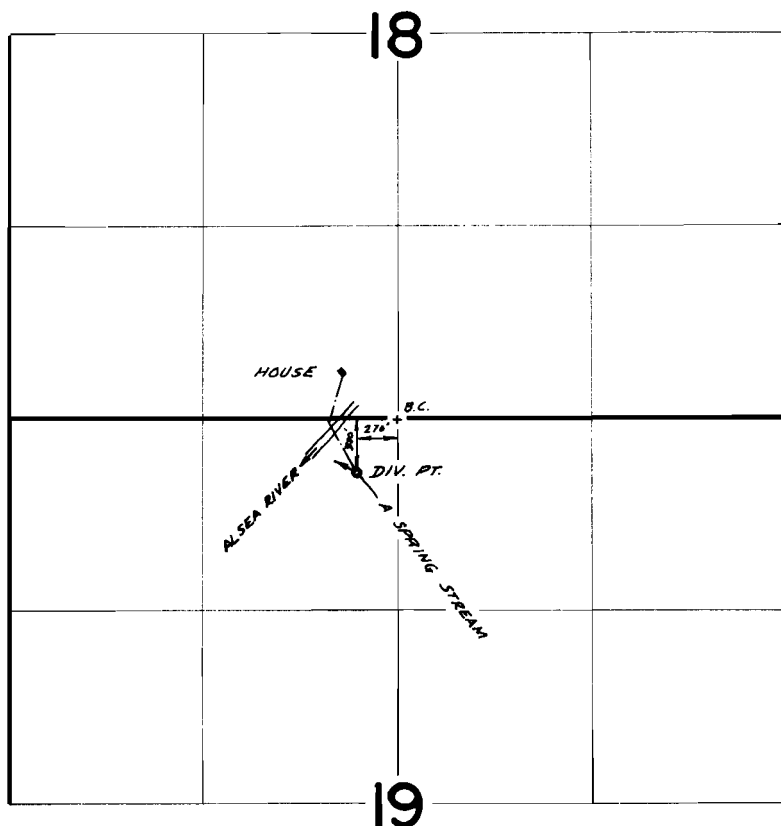

FINAL PROOF SURVEY
UNDER

Application No. 46113 Permit No. 34451
IN NAME OF

GEORGE S. BAKER

Surveyed APRIL 26 1973, by D. M. NORBY