


T.14S., R.5W., W.M.

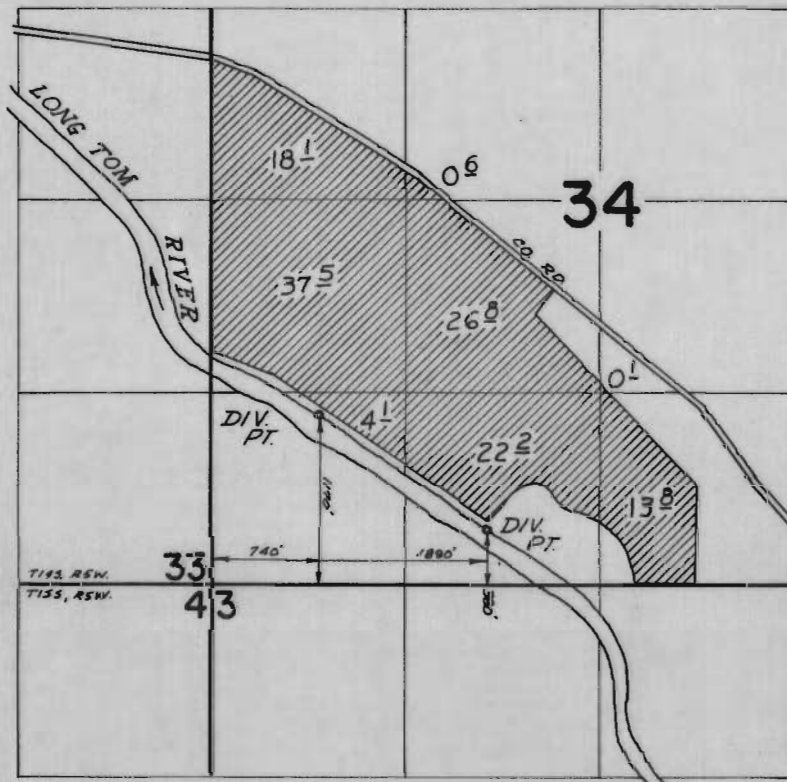

**FINAL PROOF SURVEY**  
UNDER

Application No. 47627 Permit No. 35645  
IN NAME OF

CLIFFORD E. GEORGE

Surveyed Sept 18 1973 by D. Norway