


T.14S., R. 5W., W.M.

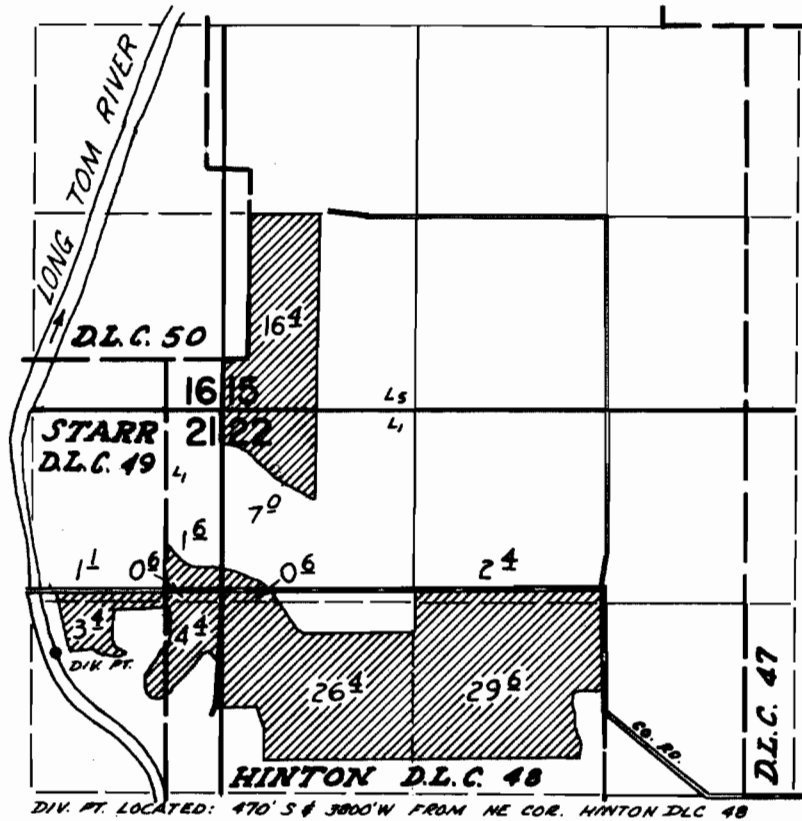

**FINAL PROOF SURVEY**  
UNDER

Application No. 47677 Permit No. 35673  
IN NAME OF

FRED M. & NETA P. GENTEMANN

Surveyed Sept. 18, 1973, by D. Norgy