T.5S. R.IE. W.M.

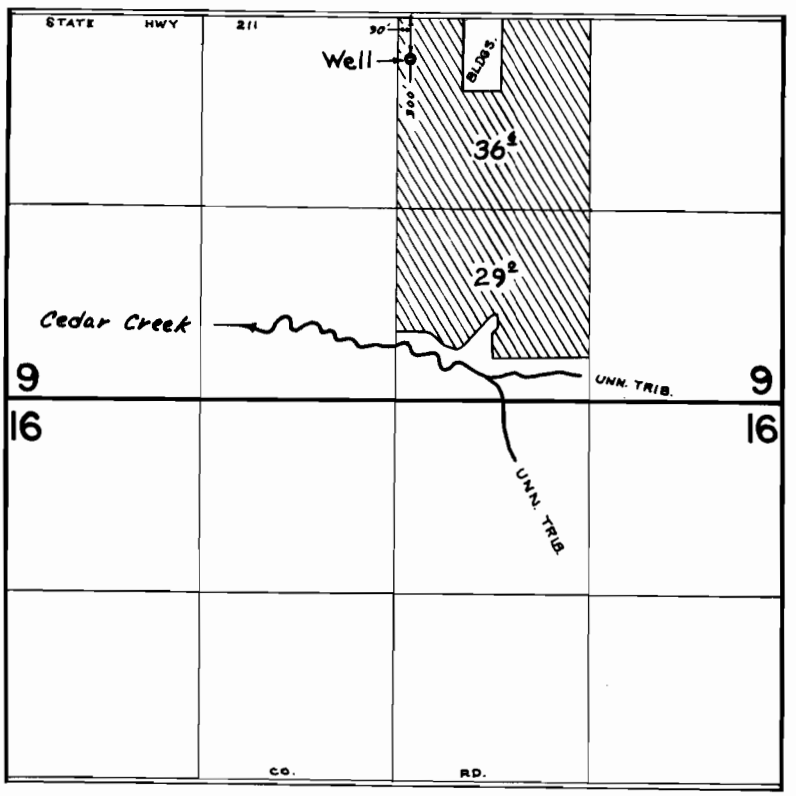

FINAL PROOF SURVEY
UNDER

Application No. G-4054 Permit No. G-3802
IN NAME OF

BRONEC BROTHERS

Surveyed JULY 16, 1974, by L.E. GOULD

DFK-2LL-151