


# T.3S. R.IE. W.M.

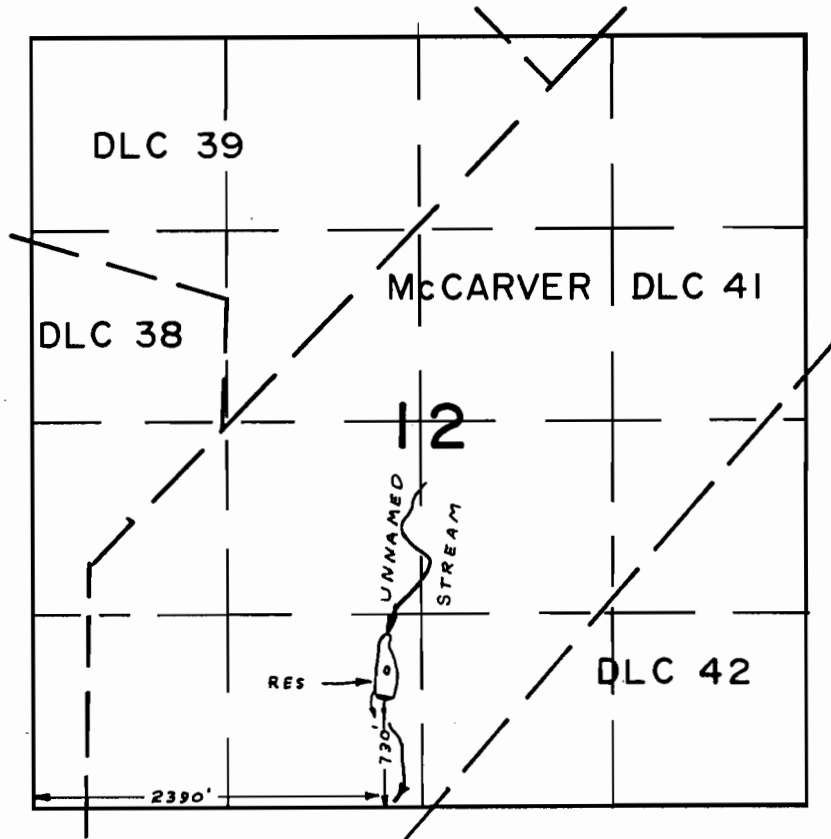

## FINAL PROOF SURVEY UNDER

R-45744                      R-5429  
Application No. 45745    Permit No. 34146

IN NAME OF  
ESTATE OF  
PAUL W. ROBERTS

Surveyed AUG 16 1974, by LH NUNN