


T.3S. R.I.E. W.M.

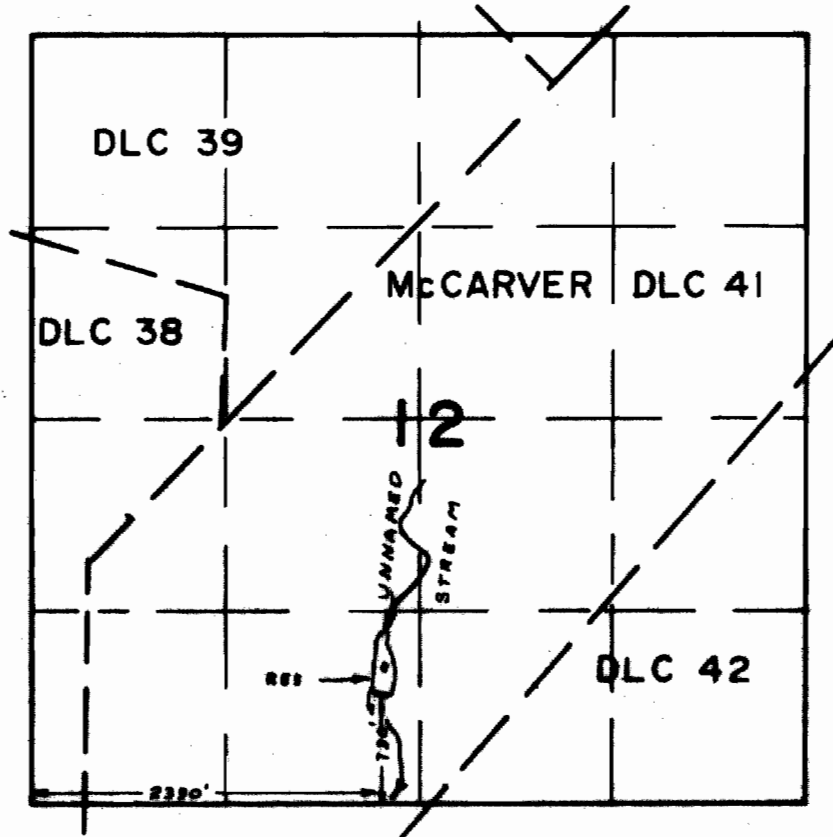

FINAL PROOF SURVEY
UNDER

R-45744 R-5429
Application No. 45745 Permit No. 34146

IN NAME OF
ESTATE OF
PAUL W. ROBERTS

Surveyed AUG 16 1974, by LH NUNN