


T.38S.,R.4W.,W.M.

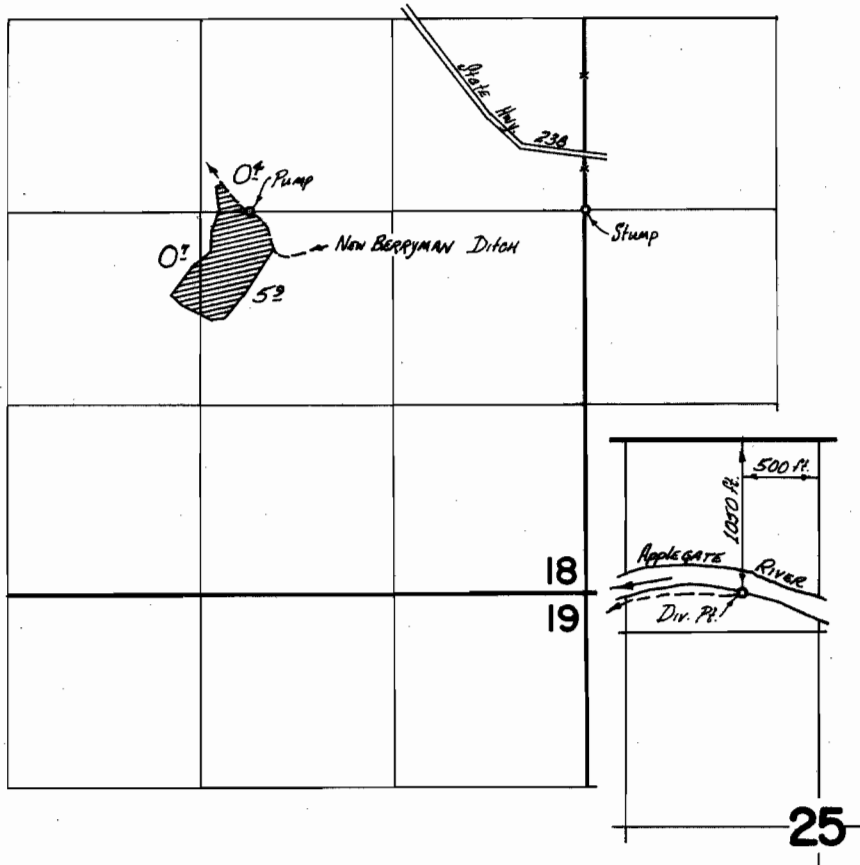

**FINAL PROOF SURVEY**  
UNDER

Application No. 45607 Permit No. 33990  
IN NAME OF

JAKE P VANDERSTOEL

Surveyed Oct 9 1973, by D. NORBY