


T.36 & 37S.R.12E.W.M.

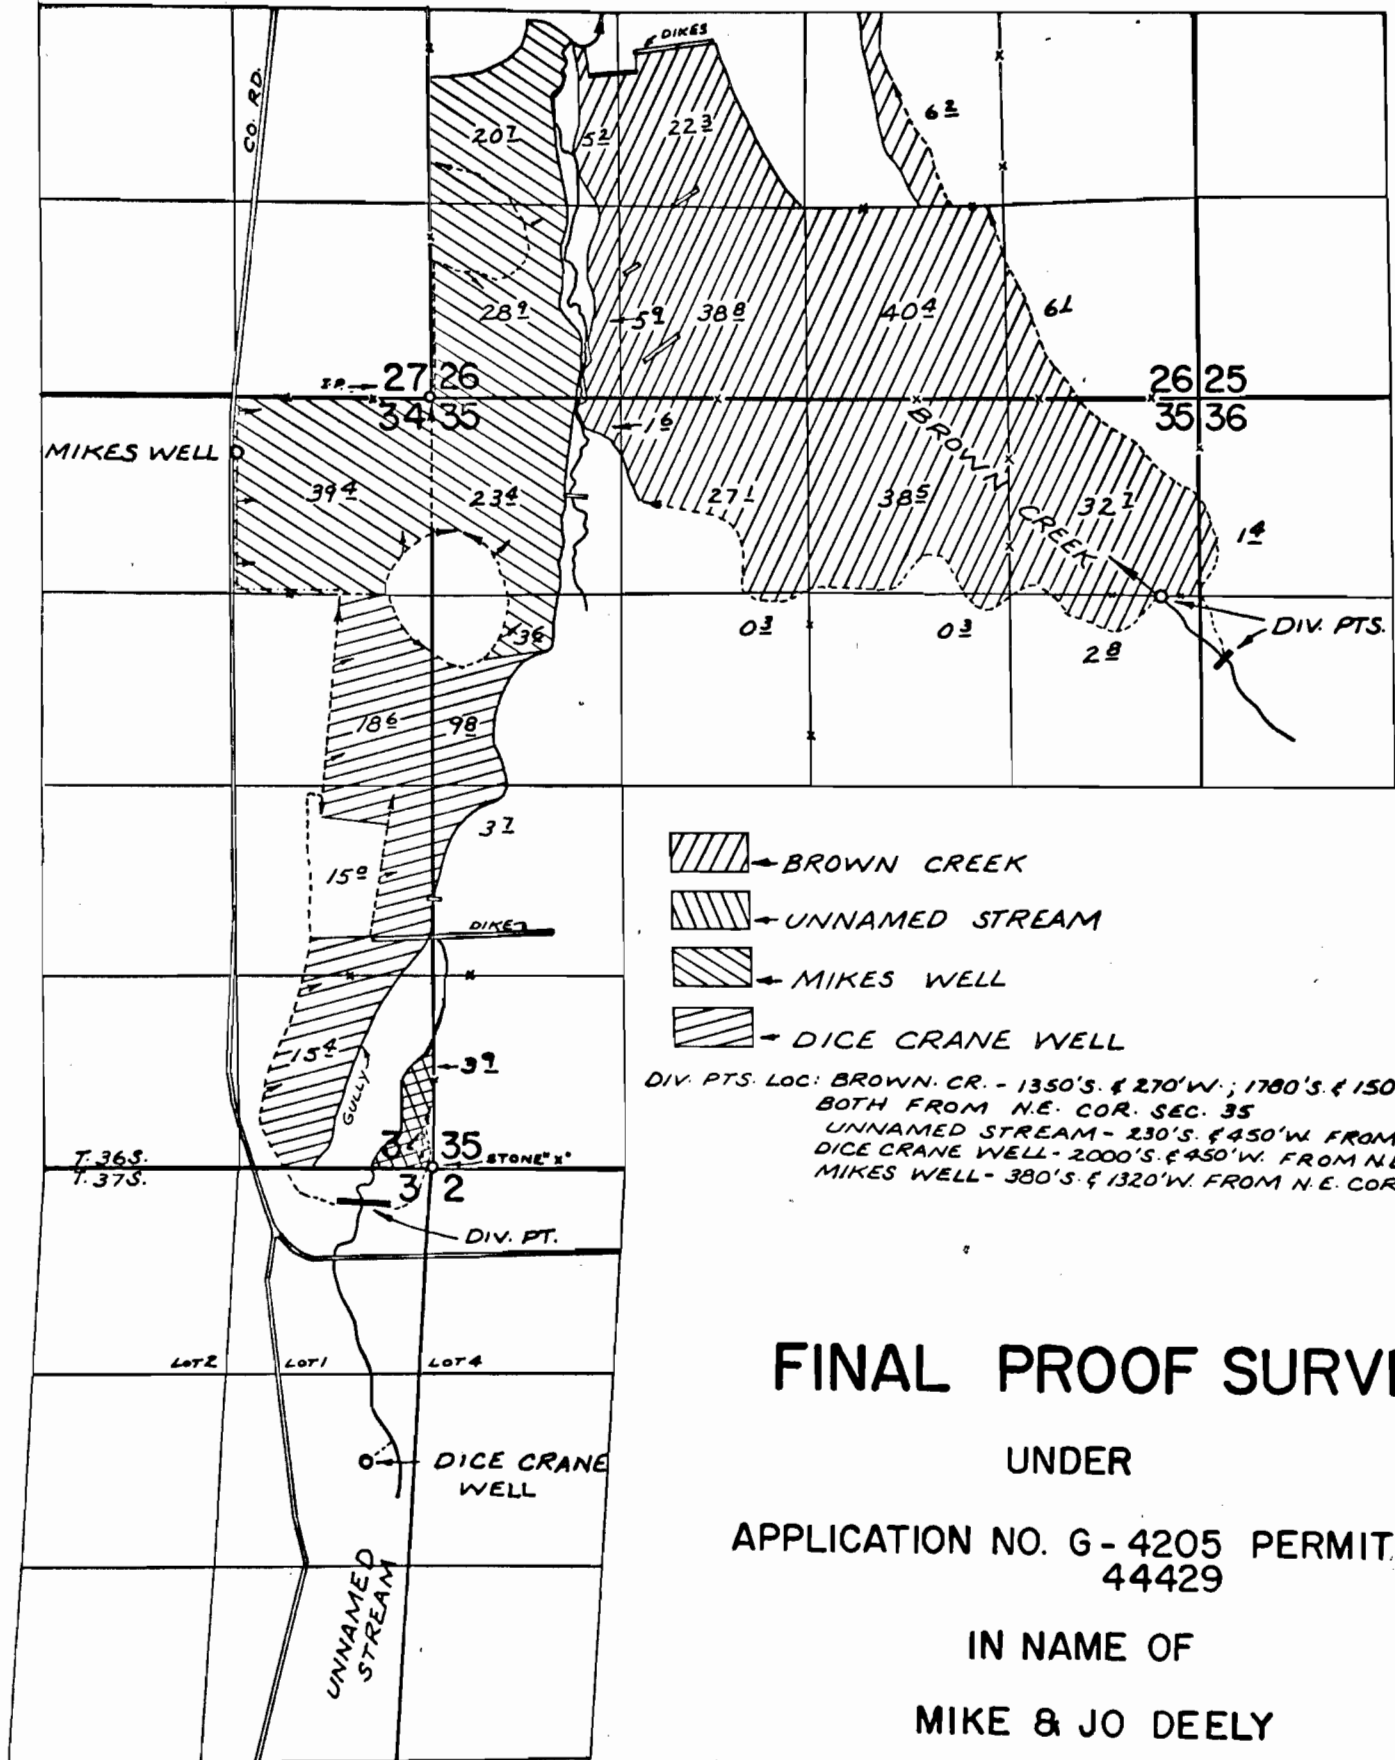

FINAL PROOF SURVEY

UNDER

APPLICATION NO. G - 4205 PERMIT NO. G-3969
 44429 33184

IN NAME OF

MIKE & JO DEELY

SURVEYED OCT. 29, 1974 BY R. MUCKEN