



T.35&36S.R.12E.W.M.

34

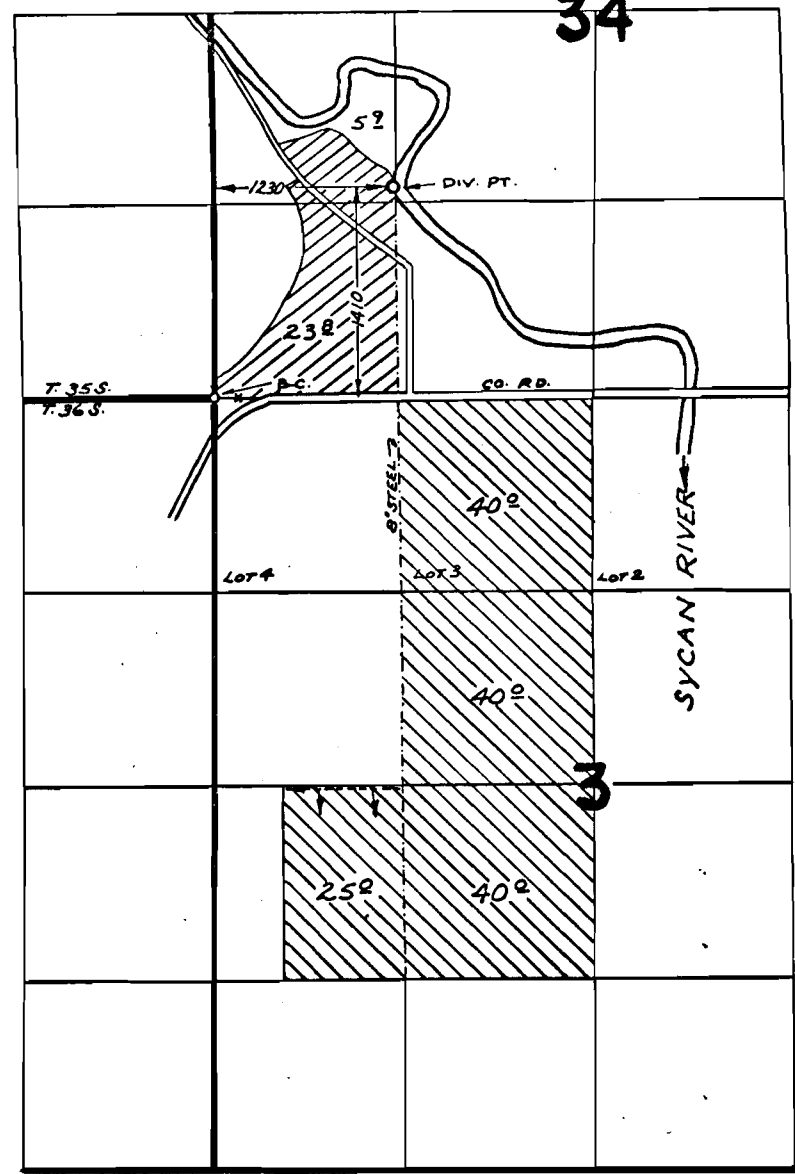

Sycan R. below Sycan Marsh

PRIMARY  SUPPLEMENTAL 

FINAL PROOF SURVEY UNDER

Application No. 41439..... Permit No. 31116.....
IN NAME OF

GLEN and ALDA ISRAEL and PHILIP ISRAEL

Surveyed OCT. 23, 1974., by *R. MUCKEN.*