T.36 & 37 S.R.12 E.W.M.

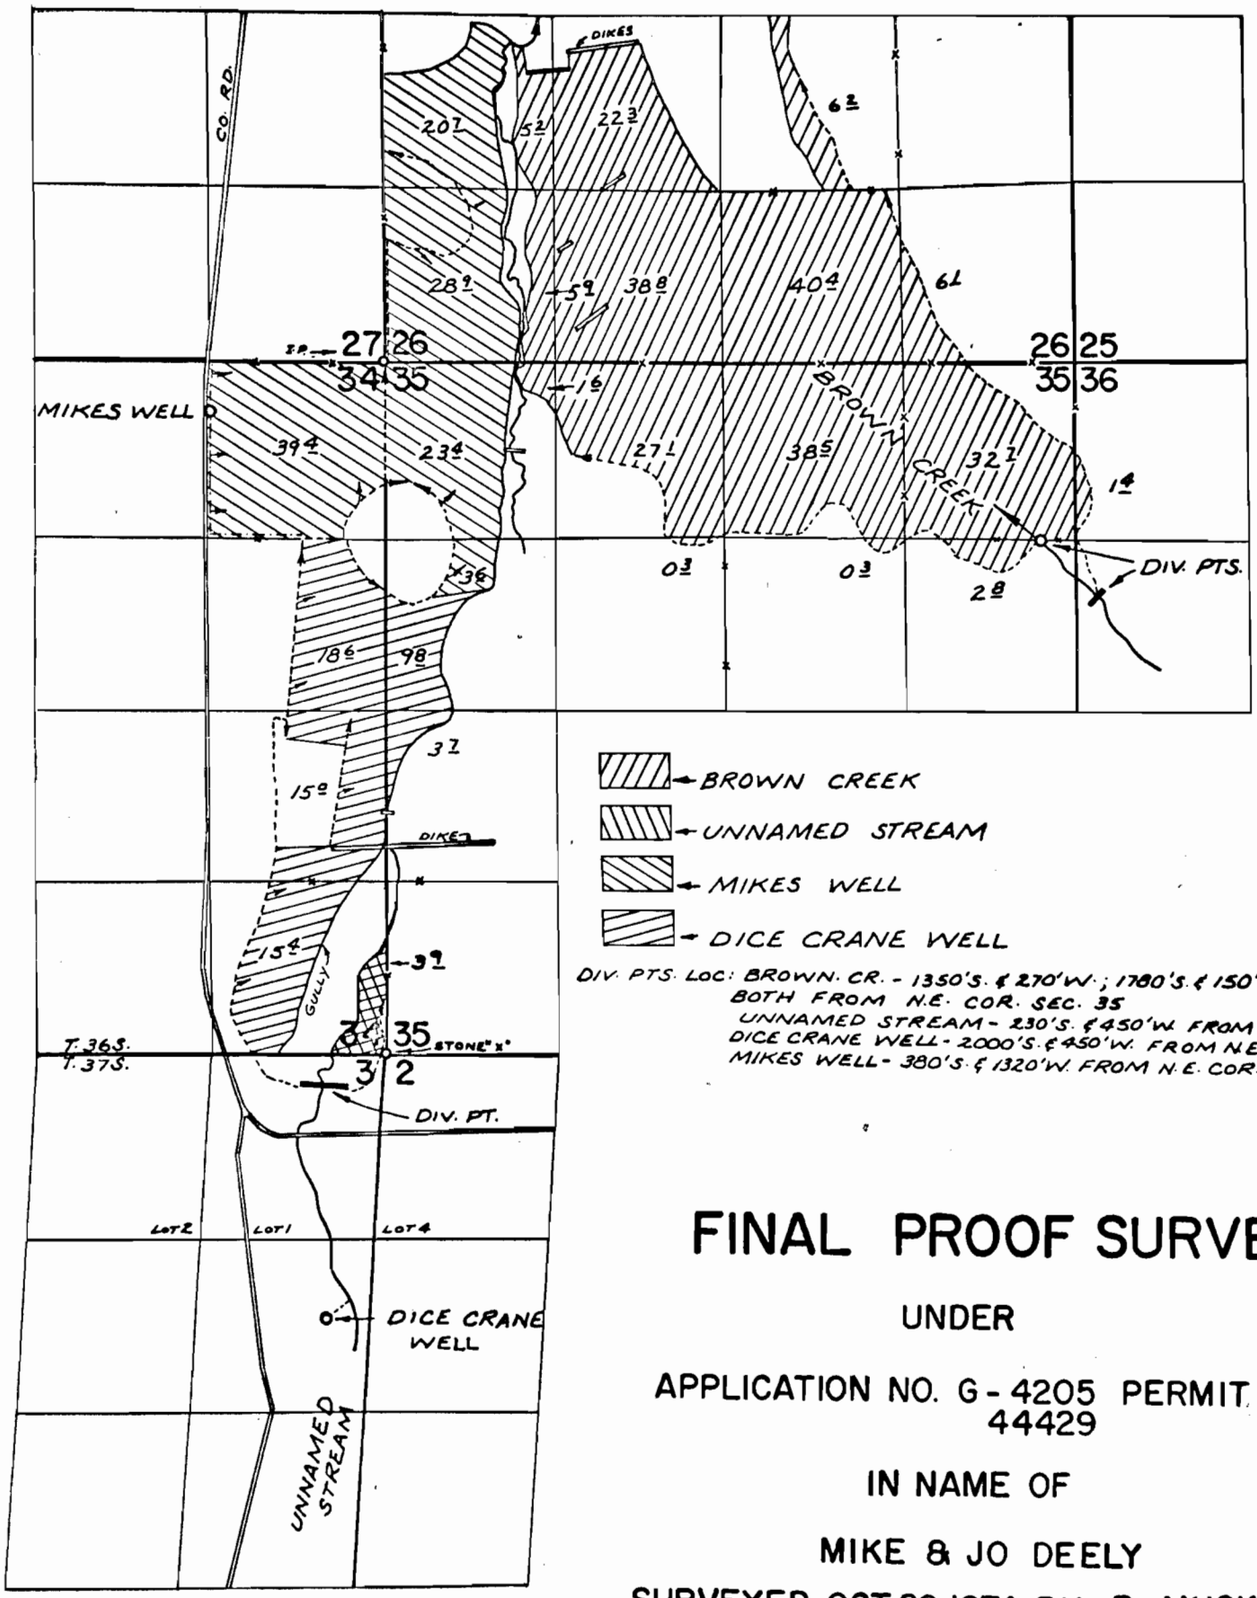

DIV. PTS. LOC: BROWN. CR. - 1350'S. & 270'W.; 1780'S. & 150'E., BOTH FROM N.E. COR. SEC. 35
UNNAMED STREAM - 230'S. & 450'W. FROM N.E. COR. SEC. 3
DICE CRANE WELL - 2000'S. & 450'W. FROM N.E. COR. SEC. 3
MIKES WELL - 380'S. & 1320'W. FROM N.E. COR. SEC. 34

FINAL PROOF SURVEY

UNDER

APPLICATION NO. G-4205 PERMIT NO. G-3969
44429 33184

IN NAME OF

MIKE & JO DEELY

SURVEYED OCT. 29, 1974 BY R. MUCKEN

CNO-4W-48
CNO-4W-49