


T.15S., R.5W., W.M.

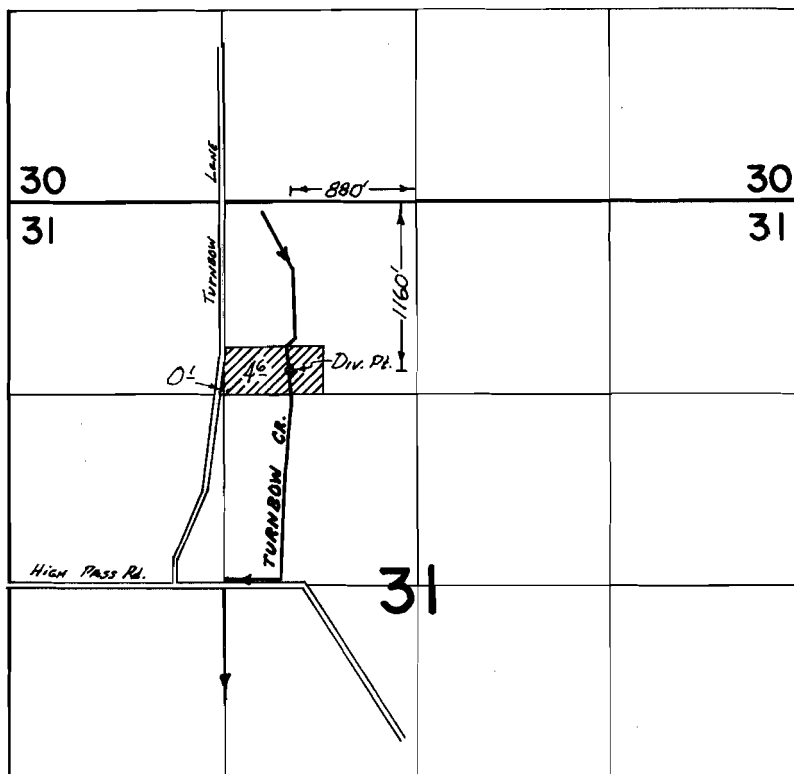

FINAL PROOF SURVEY
UNDER

Application No. 43656 Permit No. 32635
IN NAME OF

CHARLES & JOANNE ROSS

Surveyed 29 Sept. 1972, by D. NORBY