


T.6S. R.9W. W.M.

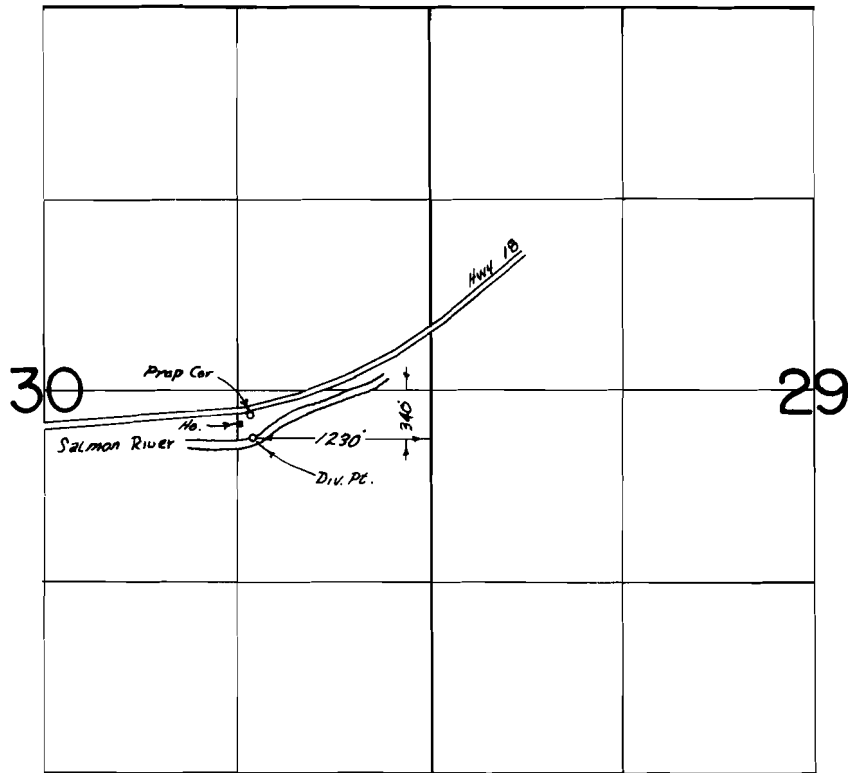

FINAL PROOF SURVEY
UNDER

Application No. 45465 Permit No. 33928
IN NAME OF

F. E. JENNINGS

Surveyed July 15 1974, by D. M. NORBY