


Township 17 S Range 24 E W. M.

Township 17 S Range 24 E W. M.

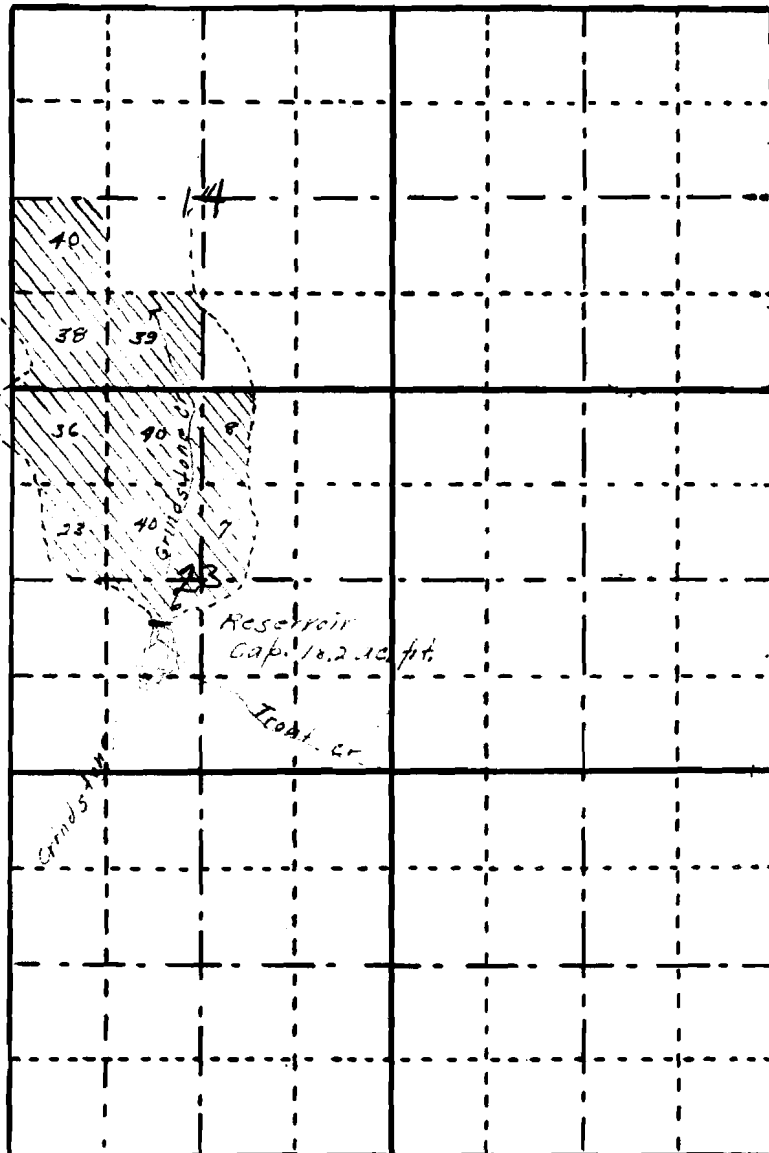

SECTION NUMBERS SHOULD BE FILLED IN WHEN USING THIS FORM

Application 431

Permit 167

Cert 420

1909

167