


T.11S., R.4W., W.M.

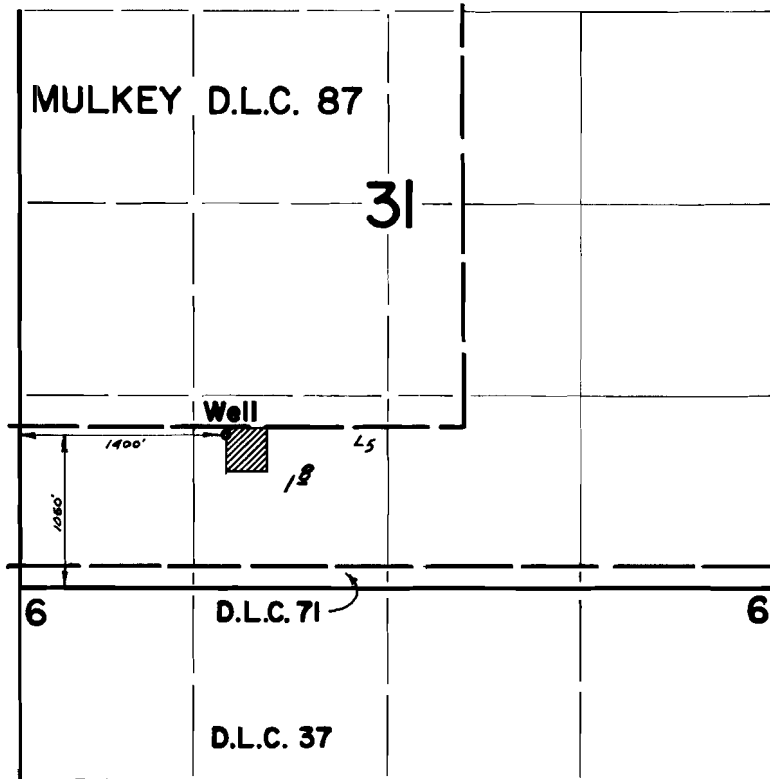

FINAL PROOF SURVEY UNDER

Application No. G-4480 Permit No. G-4222
IN NAME OF

EDLIN L. AND RAMONA PETERSON

Surveyed Oct. 2, 1973, by D. Norby