


T. 10 S. R. 1 W. W.M.

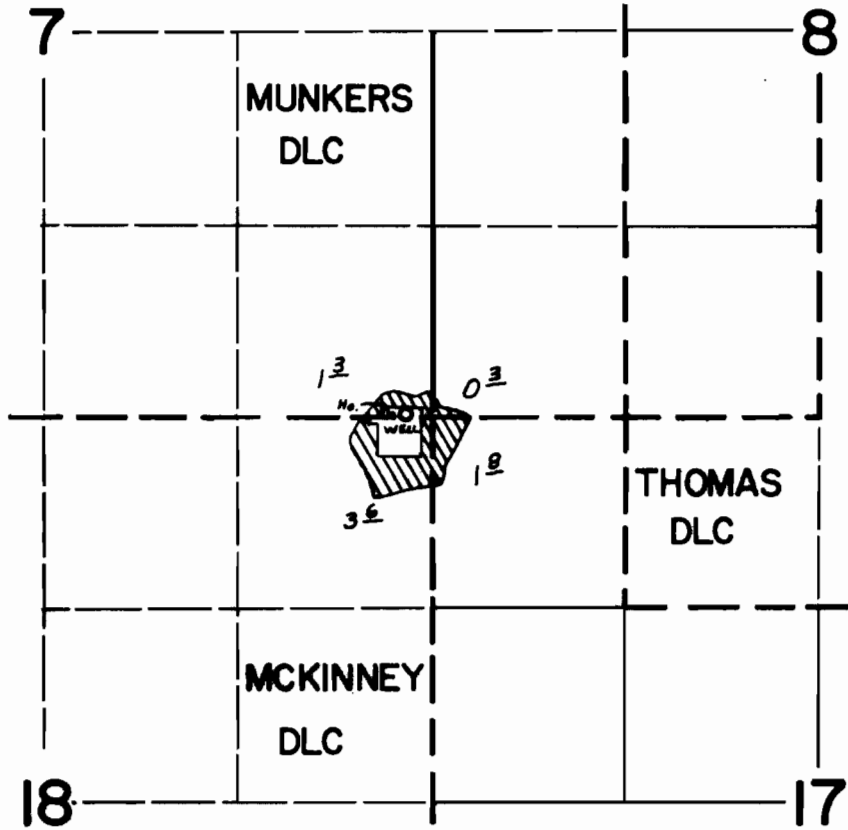

WELL LOCATED 10' N & 1300' W FROM SE COR. MUNKERS DLC

FINAL PROOF SURVEY
UNDER

Application No. G-4924 Permit No. G-4640
IN NAME OF

LESTER W. HAGEL

Surveyed JULY 26 1973, by L.E. GOULD