


T.9S., R.1E., W.M.

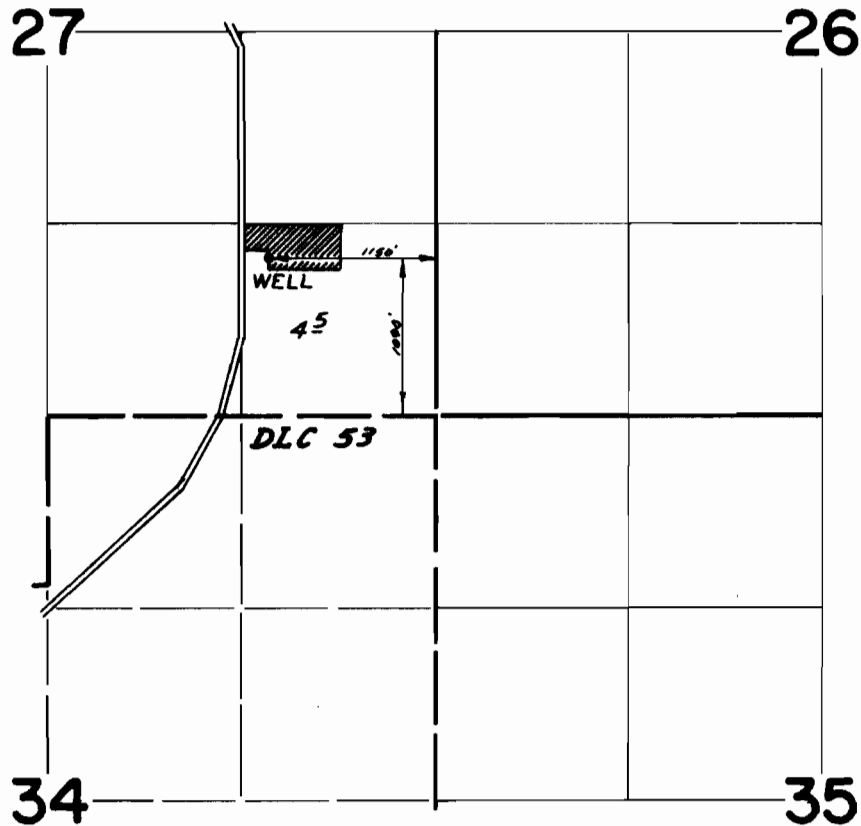

**FINAL PROOF SURVEY**  
UNDER

Application No. G-5866 Permit No. G-5020  
IN NAME OF

EARL B. MARTIN

Surveyed July 3 1973, by D. Noes