


T.11S., R.2W., W.M.

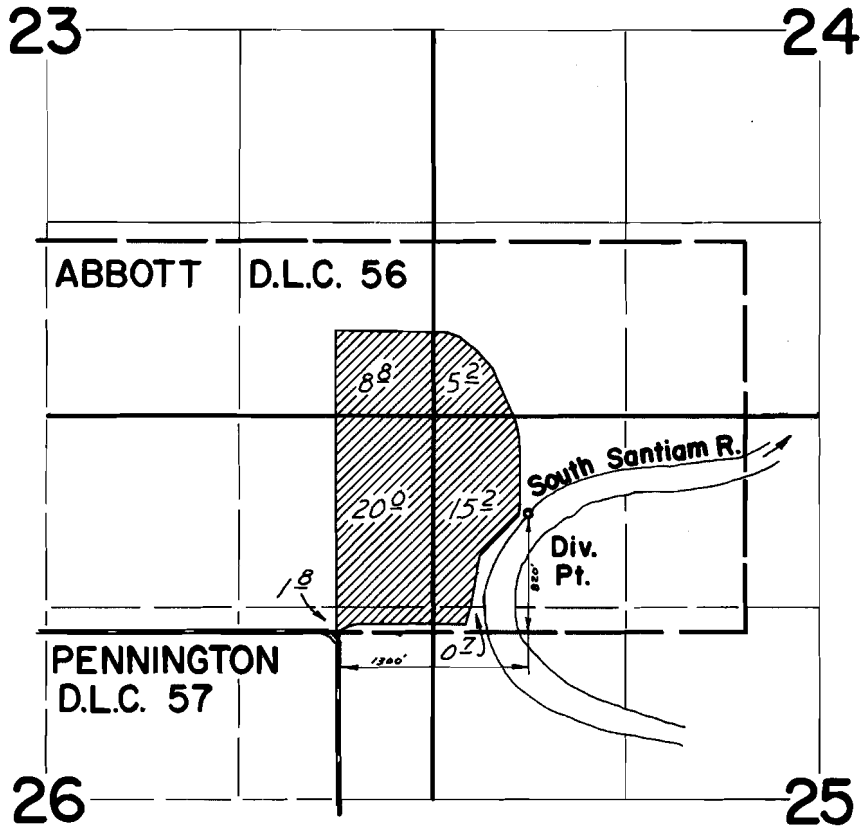

FINAL PROOF SURVEY UNDER

Application No. 43986 Permit No. 32883
IN NAME OF

CARROL AND MERTHOL L. SETTLEMIER

Surveyed June 19, 1973, by D. Norby