


T. 13 S. R. 1 E. W. M.

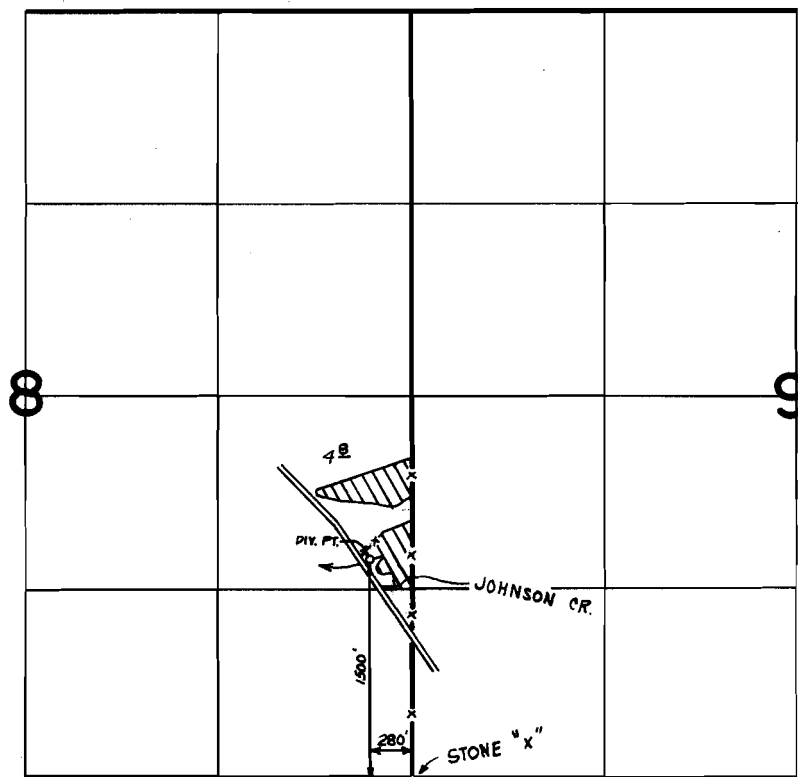

FINAL PROOF SURVEY

UNDER

Application No. 44318 Permit No. 33095
IN NAME OF _____

WILLIAM I. & JUDITH A. PHILLIPS

Surveyed MAY 7 1973, by R.G.MUCKEN