


# T. 10S., R. 2W., W.M.

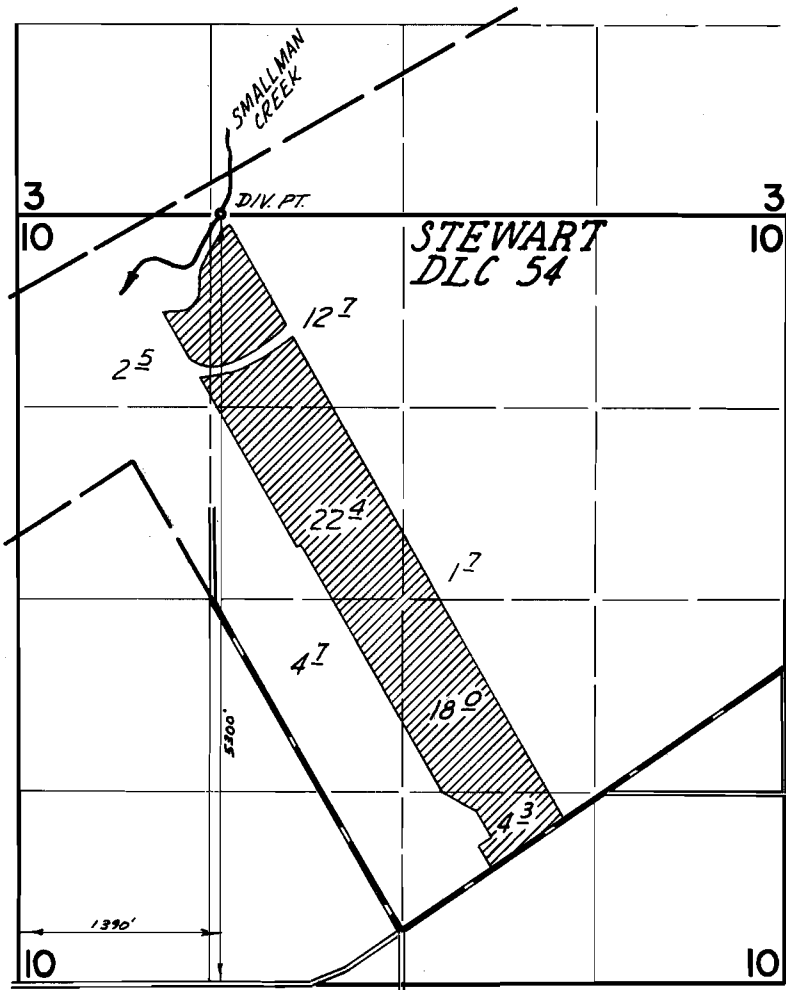

## FINAL PROOF SURVEY UNDER

Application No. 44324 Permit No. 33100  
IN NAME OF

BURL JAMES AND/OR JOSEPHINE M. EASTMAN

Surveyed June 21 1923, by D. NoeBY