



T.12S., R.1W., W.M.

T.11S., R.3W., W.M.

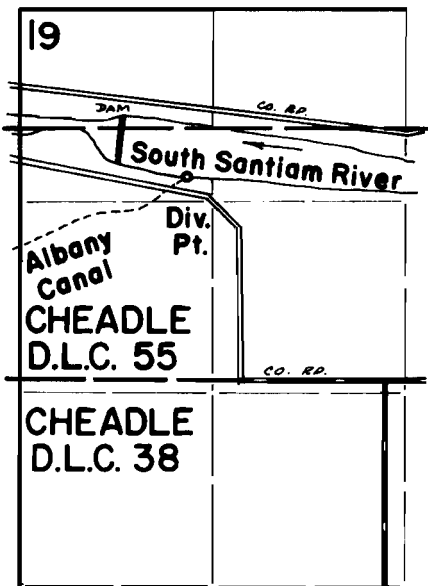

DIV. PT. LOCATED: 1400' N & 1360' W FROM NE COR. CHEADLE D.L.C. 38.

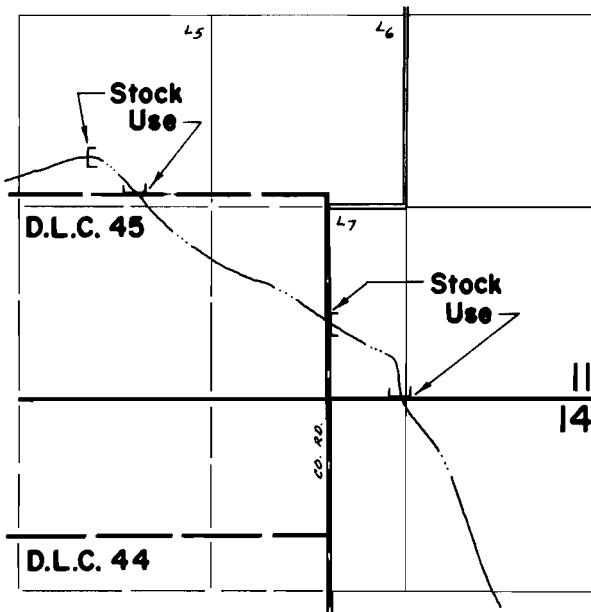

FINAL PROOF SURVEY UNDER

Application No. 45223 Permit No. 33779
IN NAME OF

DUANE R., C. S., S. E. & MARTHA EICHER

Surveyed June 22, 1973, by D. Norby