


T. 10 S., R. 1 W., W.M.

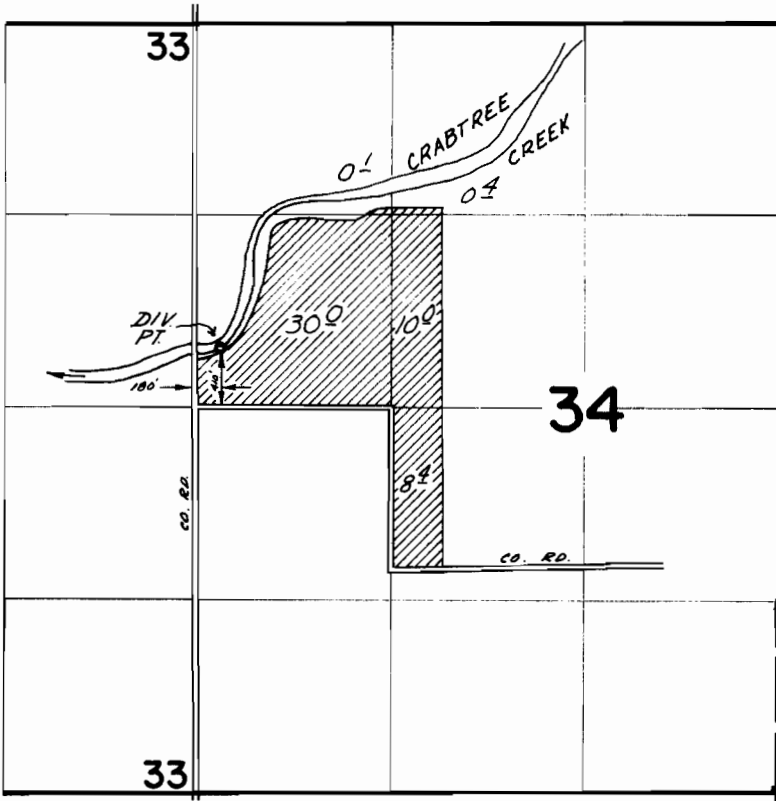

FINAL PROOF SURVEY UNDER

Application No. 4538/ Permit No. 33880
IN NAME OF

JOSEPH AND EMMA LOUISE KARNOSH

Surveyed June 20 1973, by D. Noeby