


T.13S.R.1E.W.M.

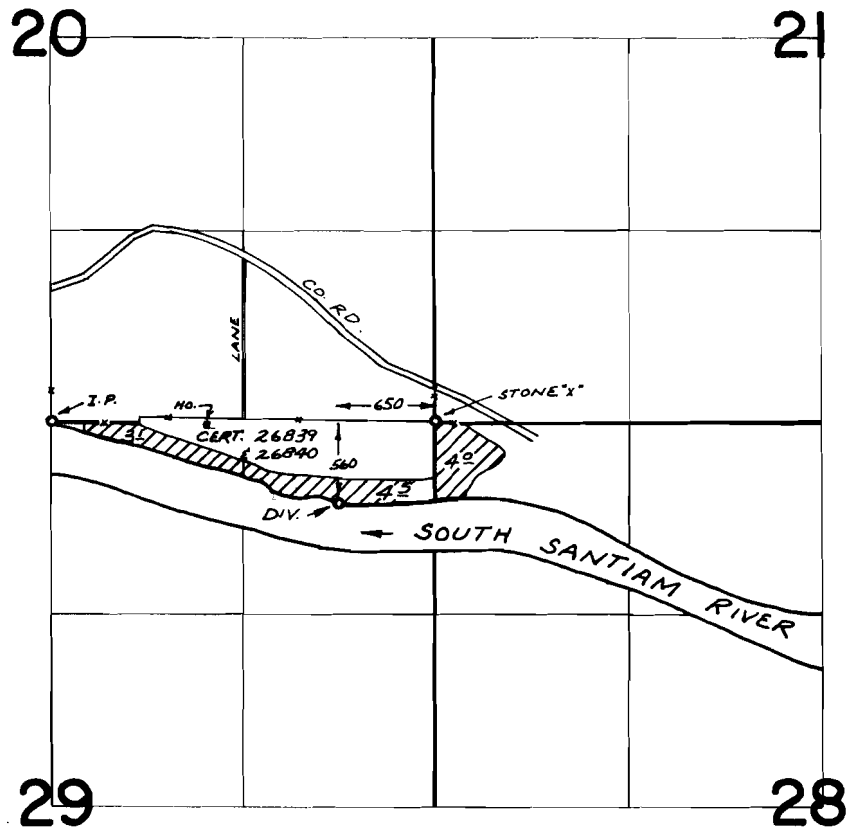

FINAL PROOF SURVEY
UNDER

Application No. 45681 Permit No. 34082
IN NAME OF

ROGER E. MATTHEWS, SR. & BETTY J. MATTHEWS

Surveyed MAY 11, 1973, by R. MUCKEN